


T. 10S., R. 6W., W.M.

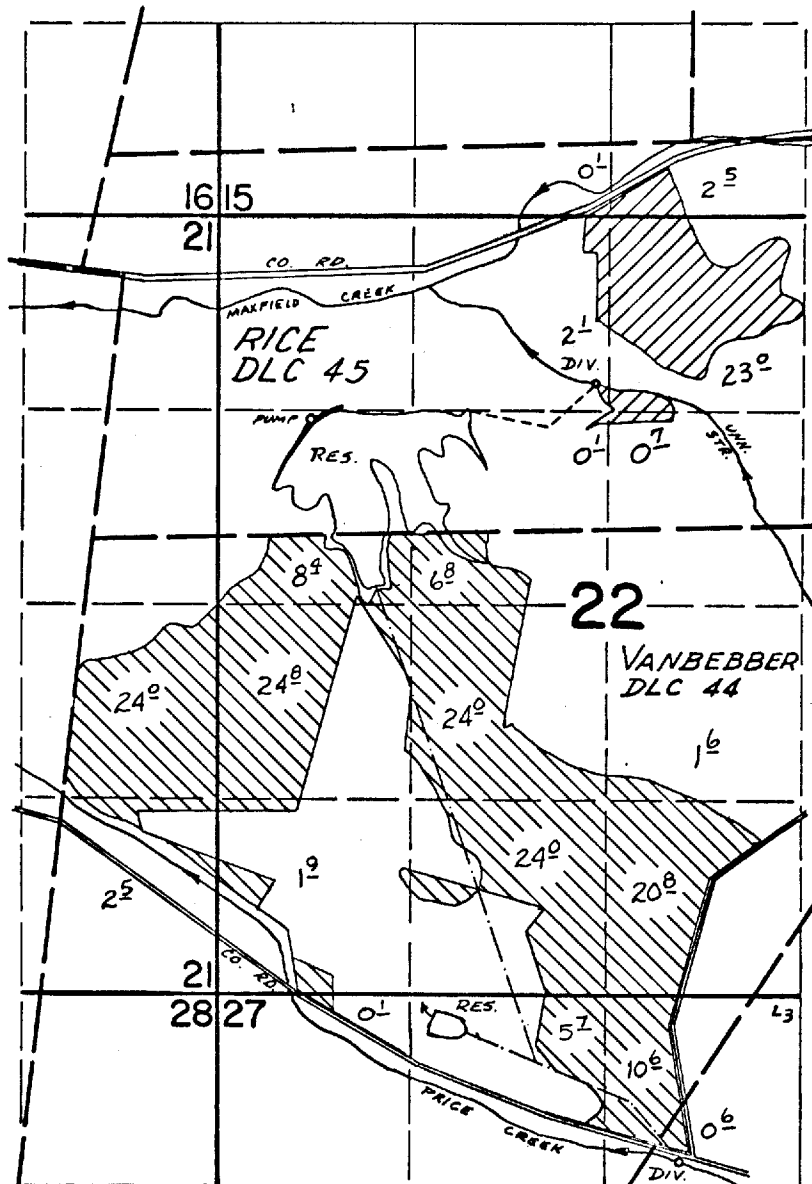

UNNAMED STR. DIV. PT. LOCATED: 4170' N & 2530' E FROM SW COR. SEC. 22.
 PRICE CR. DIV. PT. LOCATED: 1150' S & 3130' E FROM SW COR. SEC. 22.
 RES. LOCATED: 150' S & 1450' E FROM SW COR. SEC. 22.

FINAL PROOF SURVEY
 UNDER

R-42258 R-4820
 42259 31730
 Application No. 42260 Permit No. 31731
 IN NAME OF



EMORY MOORE

Surveyed MARCH 21 1973, by D. NORBY