


T. 10 S., R. 6 W., W.M.

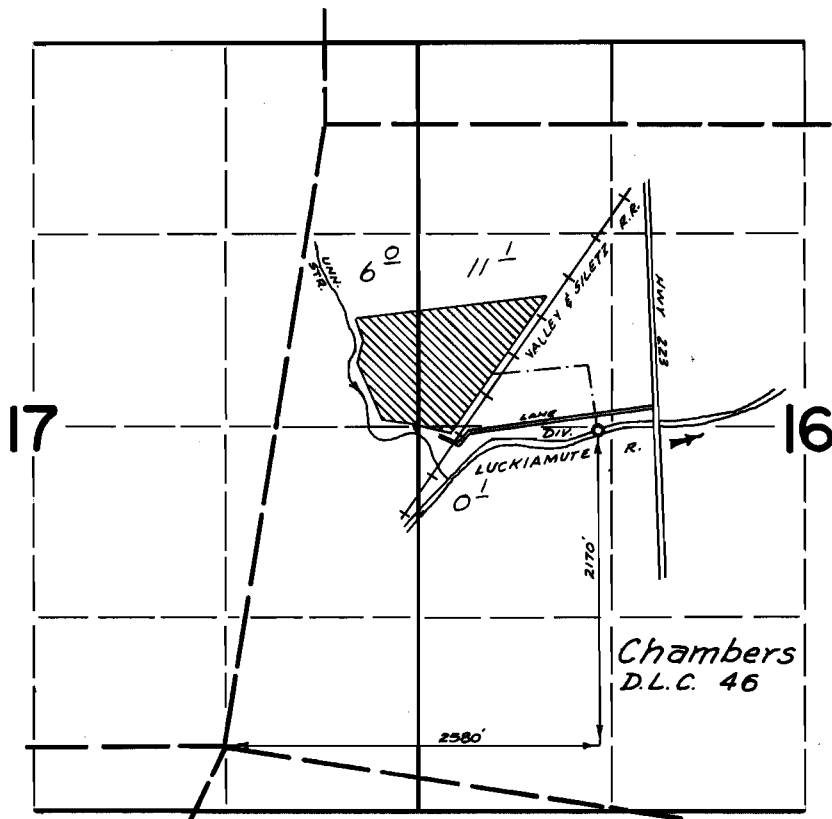

FINAL PROOF SURVEY
UNDER

Application No. 43400 Permit No. 32450
IN NAME OF

JACK F. MOORE

Surveyed Mar. 21, 1973, by D. NORSY