


T. 11 S., R. 7 W., W.M.

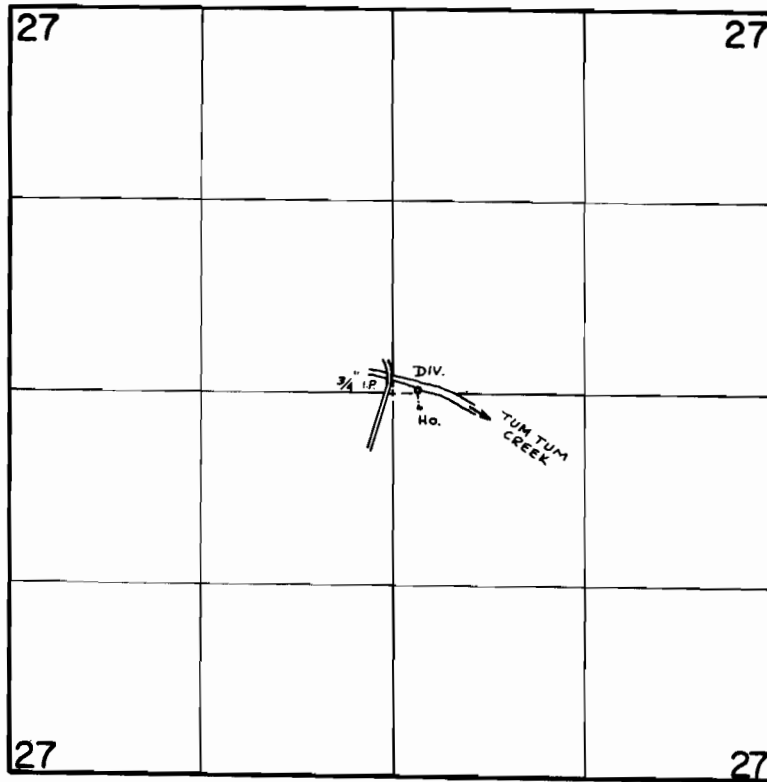

DIV. PT. LOCATED: 20' N & 160' E OF CENTER SEC. 27.

**FINAL PROOF SURVEY**  
UNDER

Application No. 44836 Permit No. 33531  
IN NAME OF

HORTON L. FROSS

Surveyed MAR 22 1973, by D. NORBY