


T.13 & 14S., R. 7W., W.M.

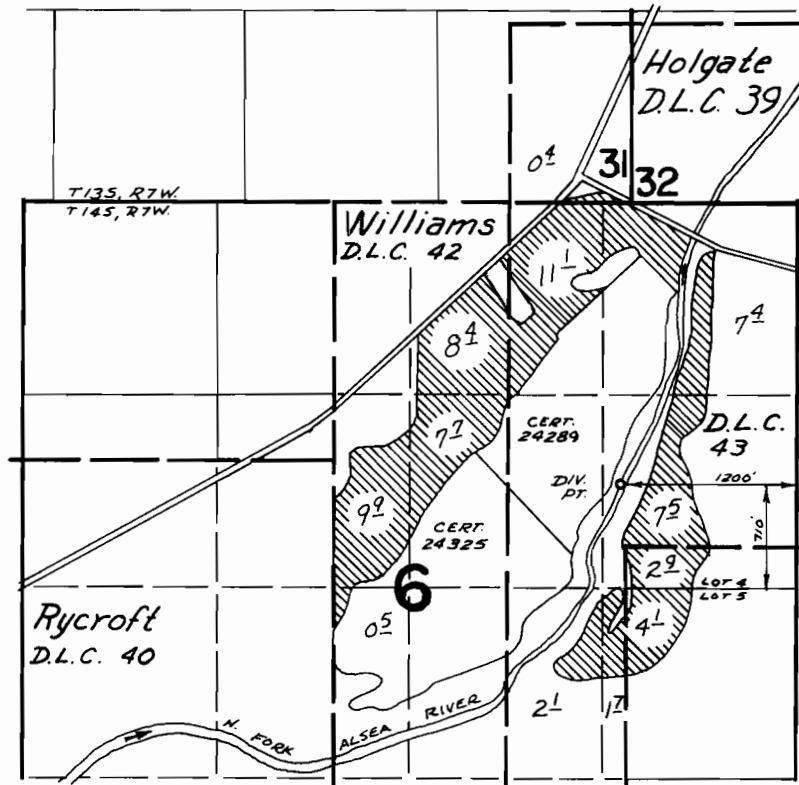

FINAL PROOF SURVEY UNDER

Application No. 46884 Permit No. 35053
IN NAME OF

JOHN and MARGUERITE O'BRIEN

Surveyed APR. 27, 1973, by D. NORBY