


T.10S., R.5W., W.M.

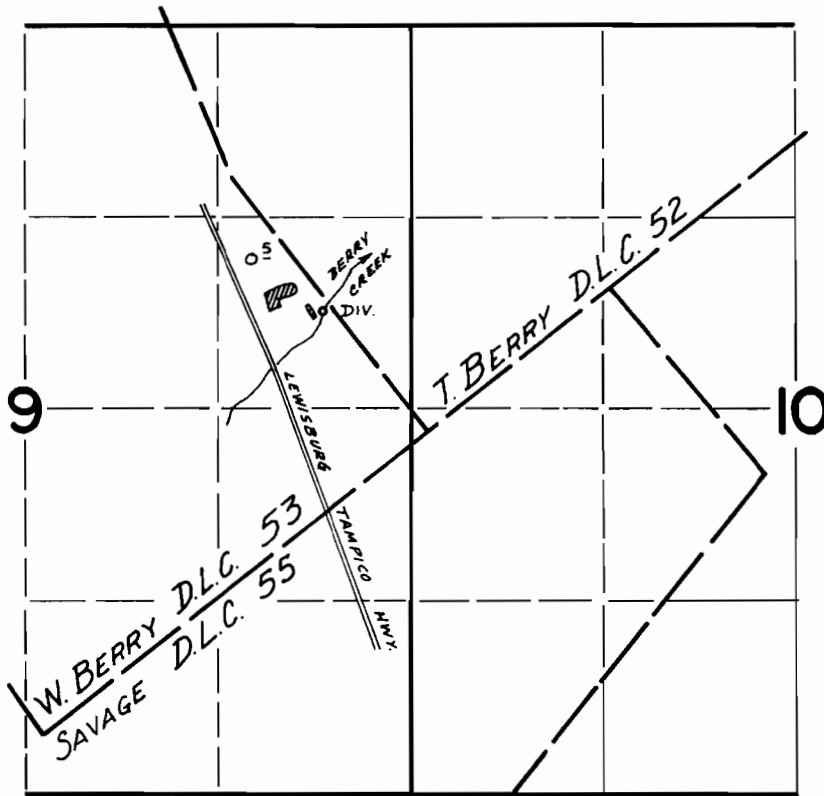

DIV. PT. LOCATED: 3330' N & 5890' W FROM SE COR SEC 10.

FINAL PROOF SURVEY
UNDER

Application No. 47411 Permit No. 35250
IN NAME OF

HOWARD E. POPE

Surveyed Aug 22 1973, by D. NORBY