


T. 10S., R. 6W., W.M.

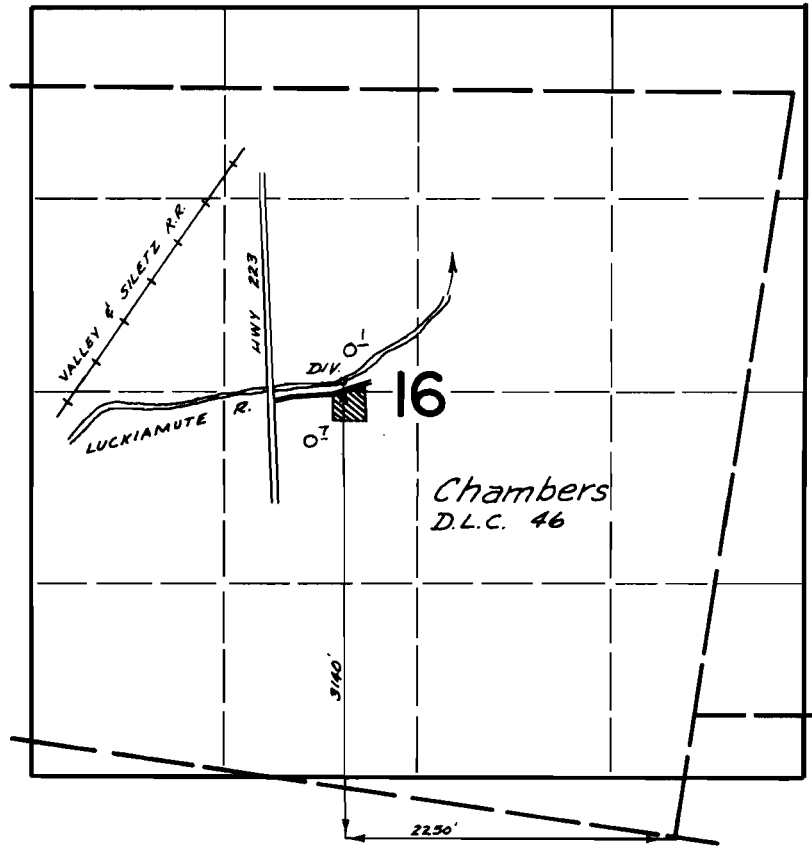

**FINAL PROOF SURVEY**  
UNDER

Application No. 47213 Permit No. 35366  
IN NAME OF

HARRY AND BERYL PINNEO

Surveyed March 21 1973, by D. Narey