
T. 10 S., R. 6 W., W.M.

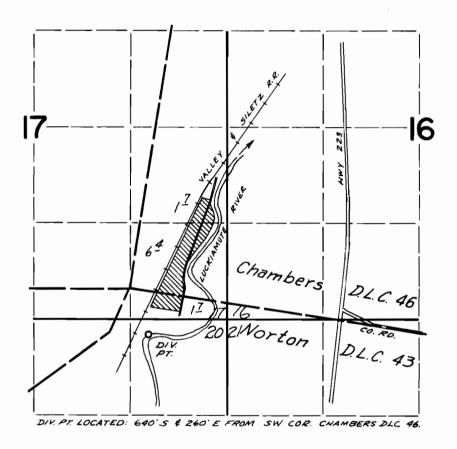

FINAL PROOF SURVEY

Application No. 48688 Permit No. 36506 IN NAME OF
ELWOOD L. BERKLUND
Surveyed AUG 22 19 73, by D. NORBY