


T. 10S., R. 6W., W.M.

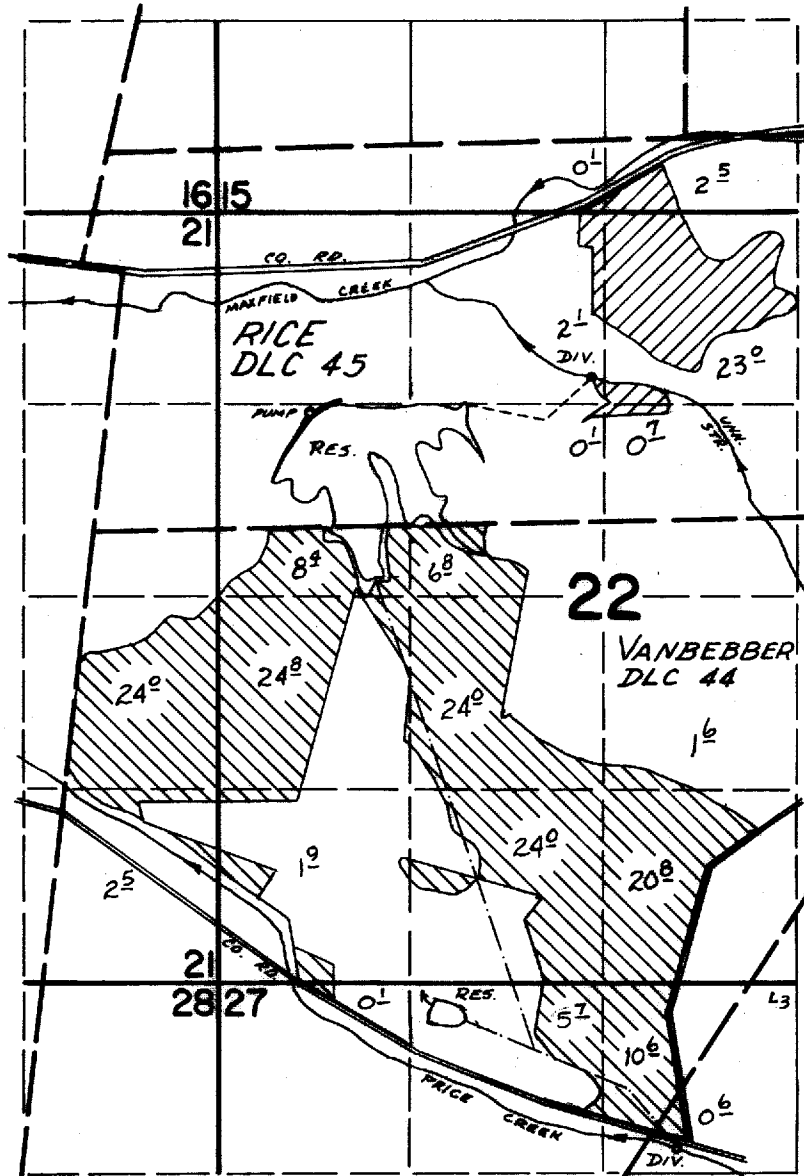

UNNAMED STR. DIV. PT. LOCATED: 4170' N & 2530' E FROM SW COR. SEC. 22.
 PRICE CR. DIV. PT. LOCATED: 1150' S & 3130' E FROM SW COR. SEC. 22.
 RES. LOCATED: 150' S & 1450' E FROM SW COR. SEC. 22.

FINAL PROOF SURVEY UNDER

R-42258	R-4820
42259	31730
Application No. 42260	Permit No. 31731

IN NAME OF
 EMORY MOORE



Surveyed MARCH 21 1973, by D. NORBY