


T. 10 S., R. 6 W., W.M.

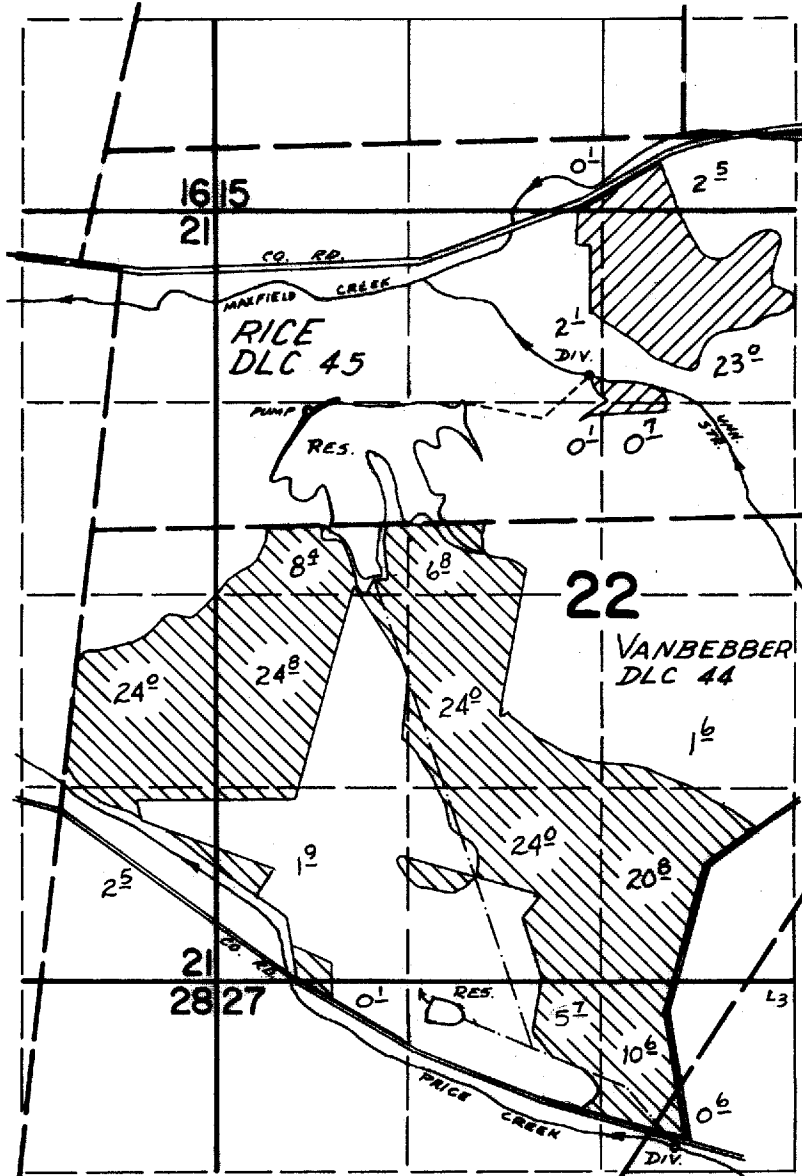

UNNAMED STR. DIV. PT. LOCATED: 4176' N & 2530' E FROM SW COR. SEC. 22.
 PRICE CR. DIV. PT. LOCATED: 1150' S & 3130' E FROM SW COR. SEC. 22.
 RES. LOCATED: 150' S & 1450' E FROM SW COR. SEC. 22.

FINAL PROOF SURVEY UNDER

| | |
|-----------------------|------------------|
| R-42258 | R-4820 |
| 42259 | 31730 |
| Application No. 42260 | Permit No. 31731 |

IN NAME OF



EMORY MOORE

Surveyed *MARCH 21* 19*73*, by *D. NORBY*