


T. 10 S., R. 4 W., W.M.

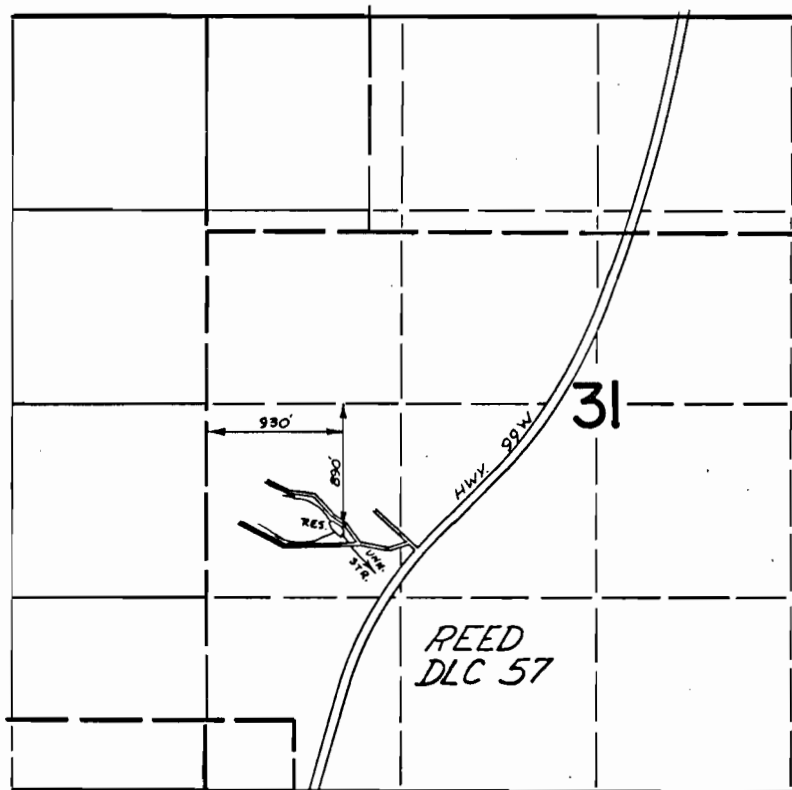

FINAL PROOF SURVEY
UNDER

Application No. R-42671 42672 Permit No. R-4845 31889
IN NAME OF

OREGON STATE UNIVERSITY

Surveyed MAR. 23 1973, by D. NORBY