T.11S., R.6W., W.M.

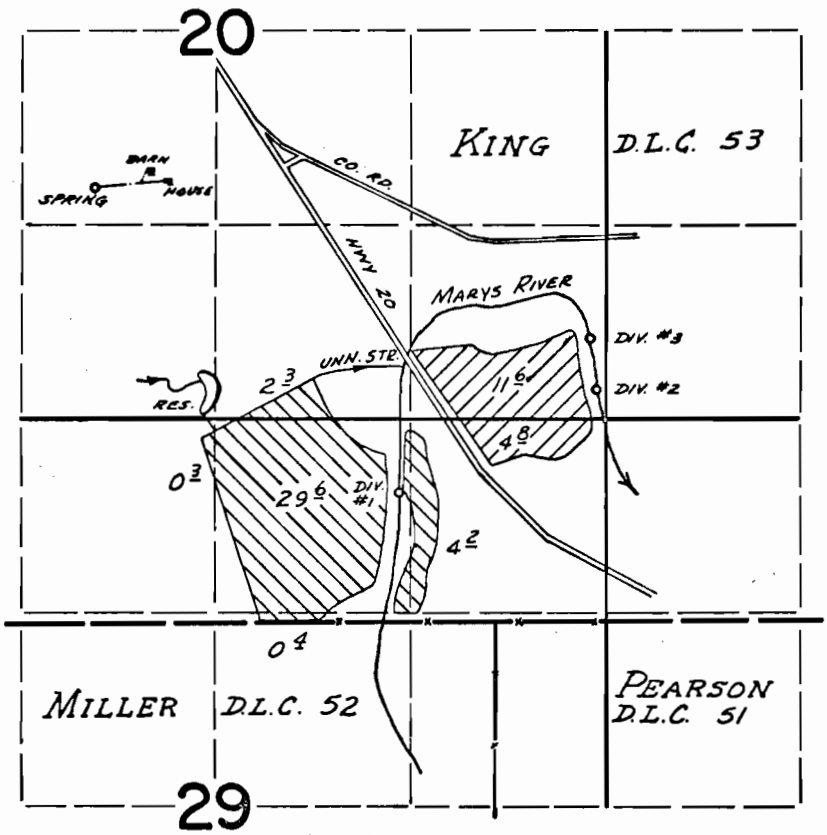

SPRING LOCATED:	2950' N & 2720' W	FROM	NW	COR	PEARSON	D.L.C.	51
RES. LOCATED:	1400' N & 1970' W	"	"	"	"	"	"
DIV. PT. 1 LOCATED:	870' N & 650' W	"	"	"	"	"	"
DIV. PT. 2 LOCATED:	1570' N & 680' E	"	"	"	"	"	"
DIV. PT. 3 LOCATED:	1930' N & 640' E	"	"	"	"	"	"

FINAL PROOF SURVEY

UNDER

42851 — R-44249 — 32026 — R-5111

Application No. 44250 Permit No. 33051

IN NAME OF

CARL F. MULLER

Surveyed March 20 1973, by D. Norby

DFJ-3LL-188