


T. 2S. R. 7E. W. M.

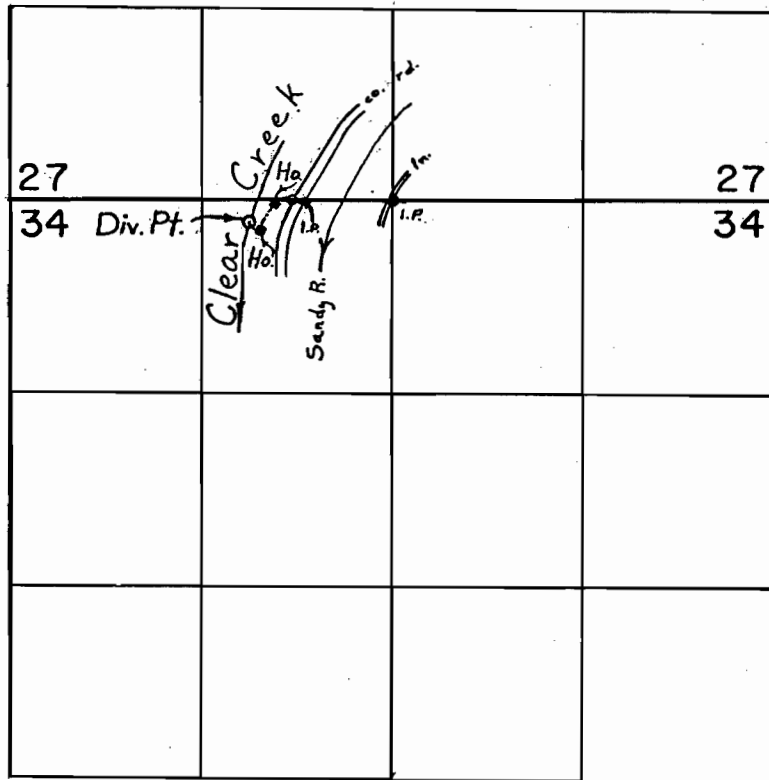

DIV. PT. LOC: 160' S. & 1000' W. FROM N. 1/4 COR. SEC. 34

FINAL PROOF SURVEY
UNDER

Application No. 38376 Permit No. 28599
IN NAME OF

Paul M. Sanders

Surveyed Sept. 11, 1973, by R. Mucken