


T. 2 S. R. 1 E. W. M.

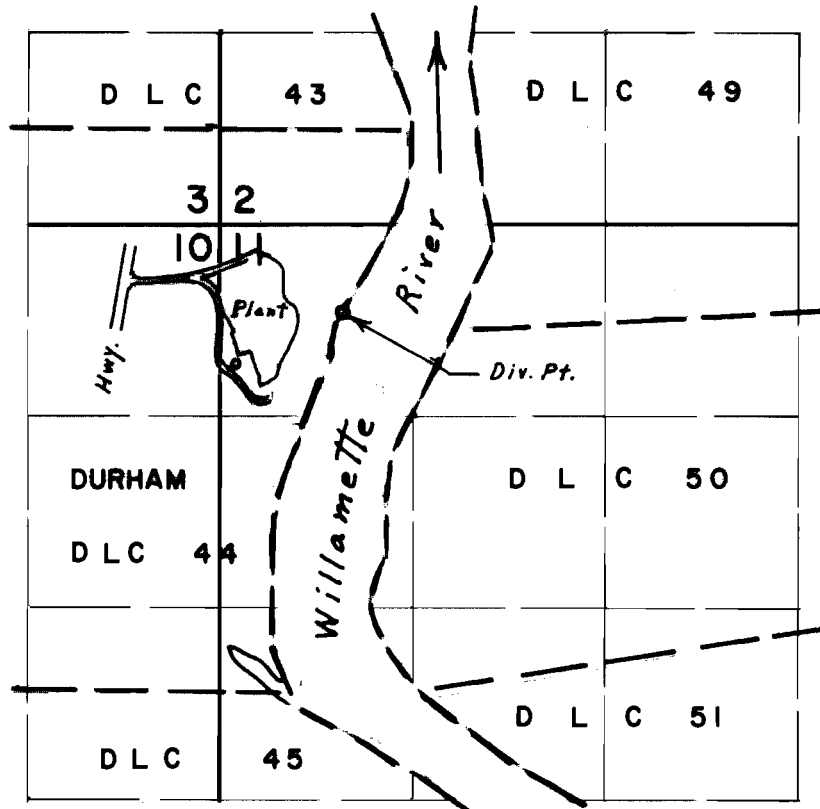

FINAL PROOF SURVEY UNDER

Application No. 42168 Permit No. 31556
IN NAME OF

OREGON PORTLAND CEMENT COMPANY

Surveyed Sept. 14, 1972, by L. E. Gould