


T.4&5S.R.3E.W.M.

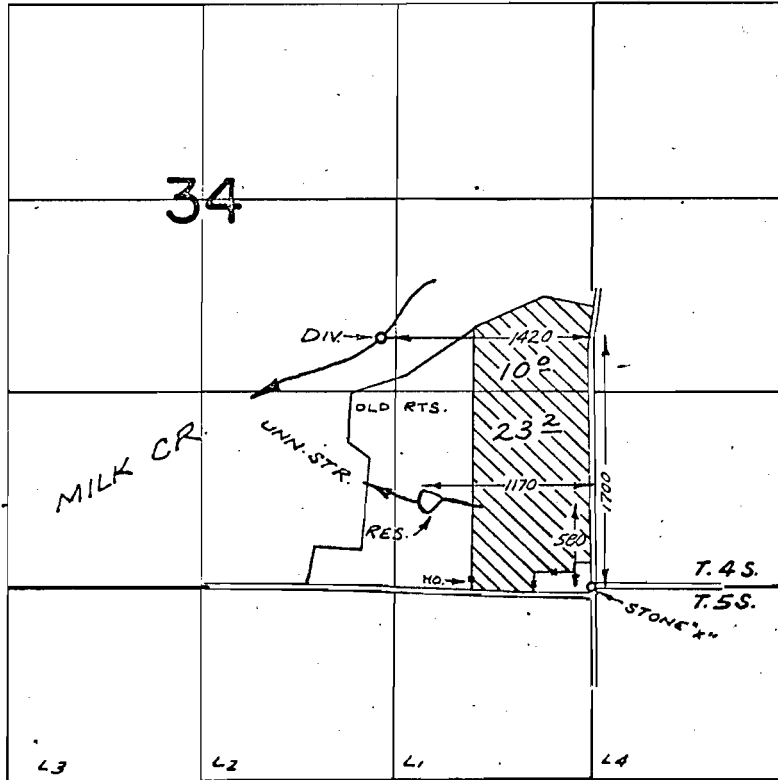

FINAL PROOF SURVEY
UNDER

44200 33023
R-48400 R-5881
Application No. 48401 Permit No. 36345
IN NAME OF

.....ROGNAR F. ANDERSON.....

Surveyed July 26, 1973, by R. MUGGEN