


T.3S. R.3E. W.M.

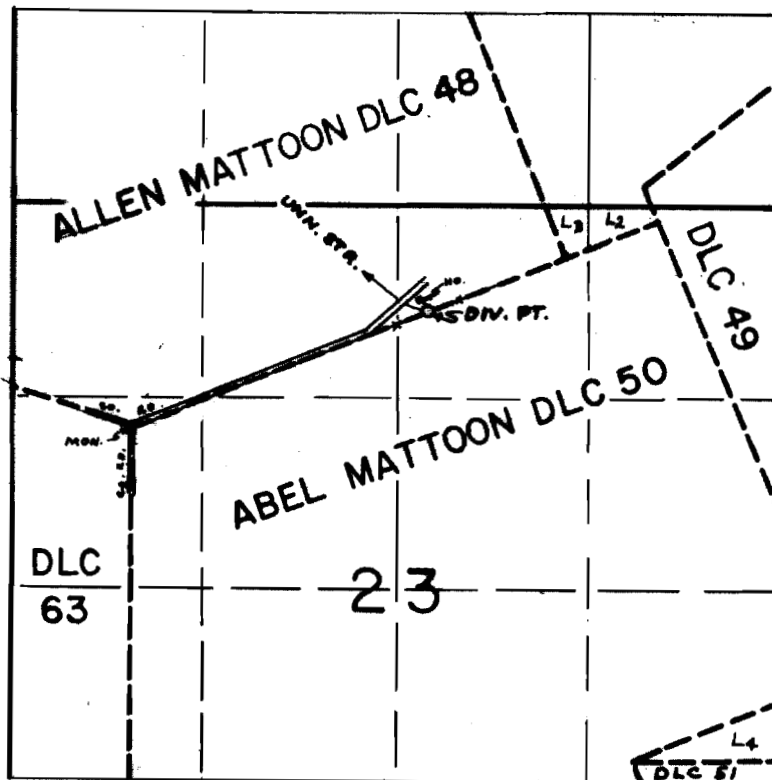

DIV. PT. LOC: 800' N. & 2030' E. FROM S. COR. ALLEN MATTOON DLC 48

FINAL PROOF SURVEY
UNDER

Application No. 46405 Permit No. 34673
IN NAME OF

JACK M. GROVES

Surveyed AUG. 16, 1973, by R. MUCKEN