


T.2S. R.5E. W.M.

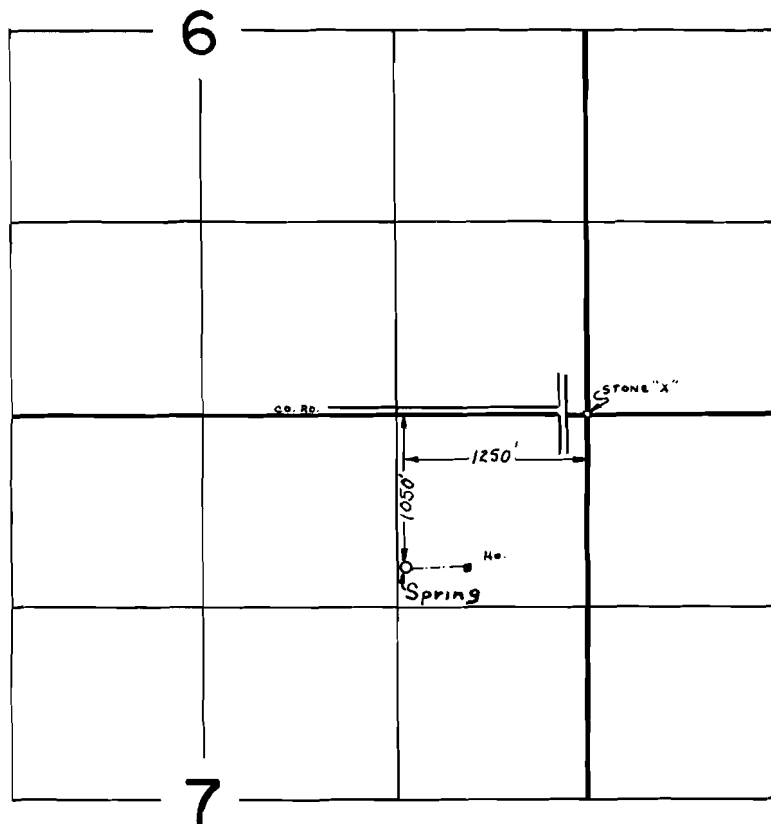

FINAL PROOF SURVEY
UNDER

Application No. 47329 Permit No. 35455
IN NAME OF

MALCOLM D. Mac GREGOR

Surveyed SEPT. 12, 1973, by R. MUCKEN