


T.3S. R.3E. W.M.

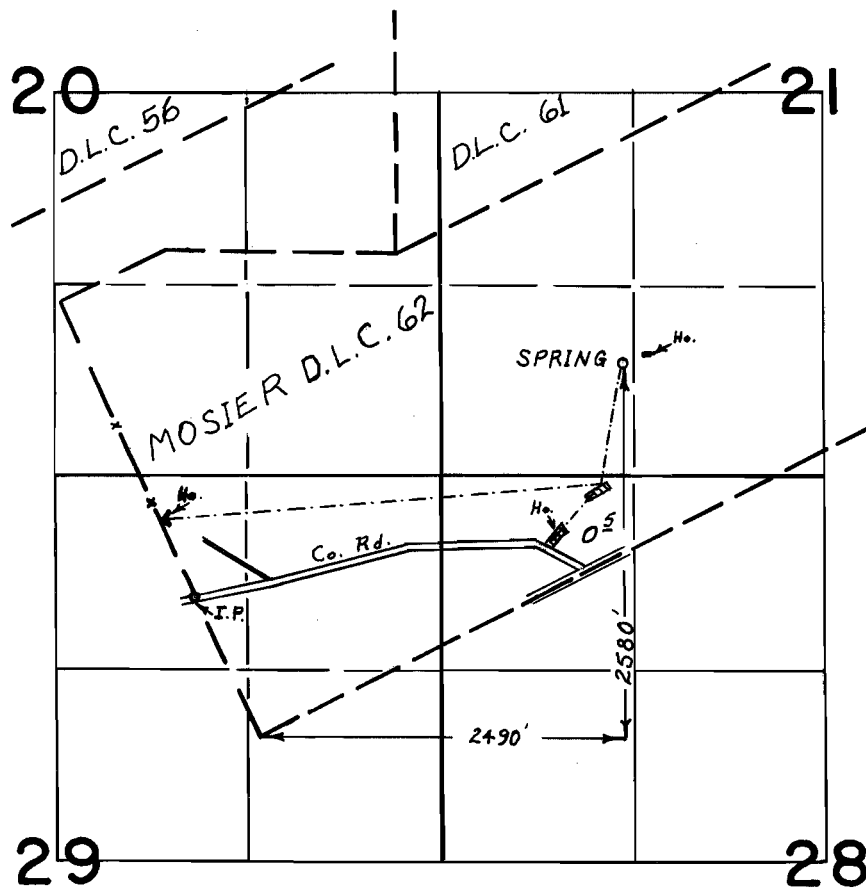

FINAL PROOF SURVEY
UNDER

Application No. 42854 Permit No. 35264
IN NAME OF

W. KIRK BRAUN

Surveyed Aug. 16 1973, by R. MUCKEN