


T.3S.R.4E.W.M.

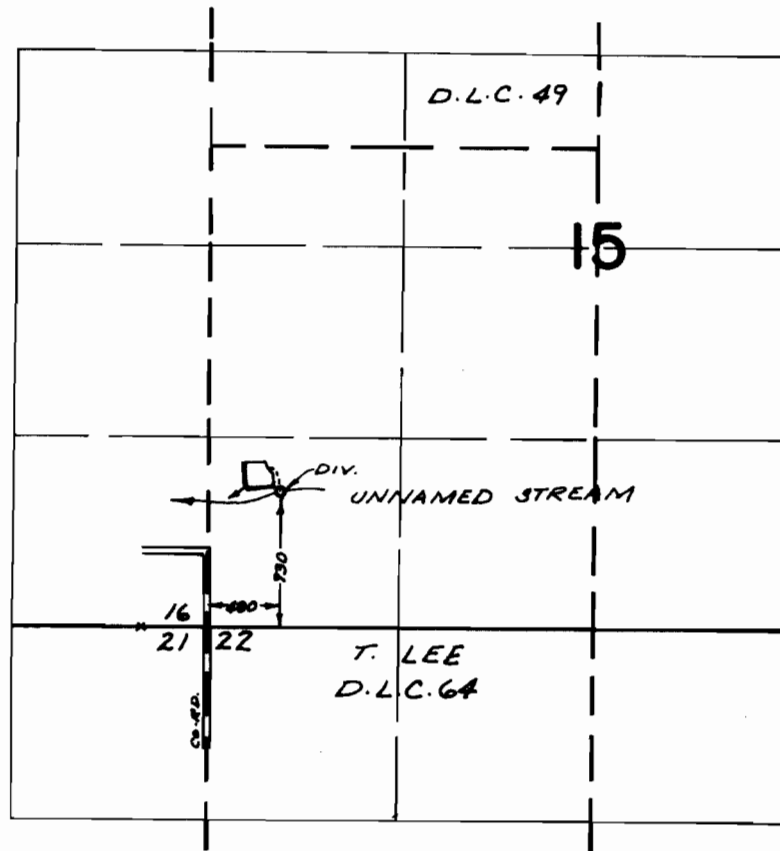

FINAL PROOF SURVEY

UNDER

Application No. R-46304 Permit No. R-4672
IN NAME OF

CLYDE R. & MILDRED L. LEWIS

Surveyed AUG. 15 1973, by R. MUCKEN