


T.4S.R.1&2E.W.M.

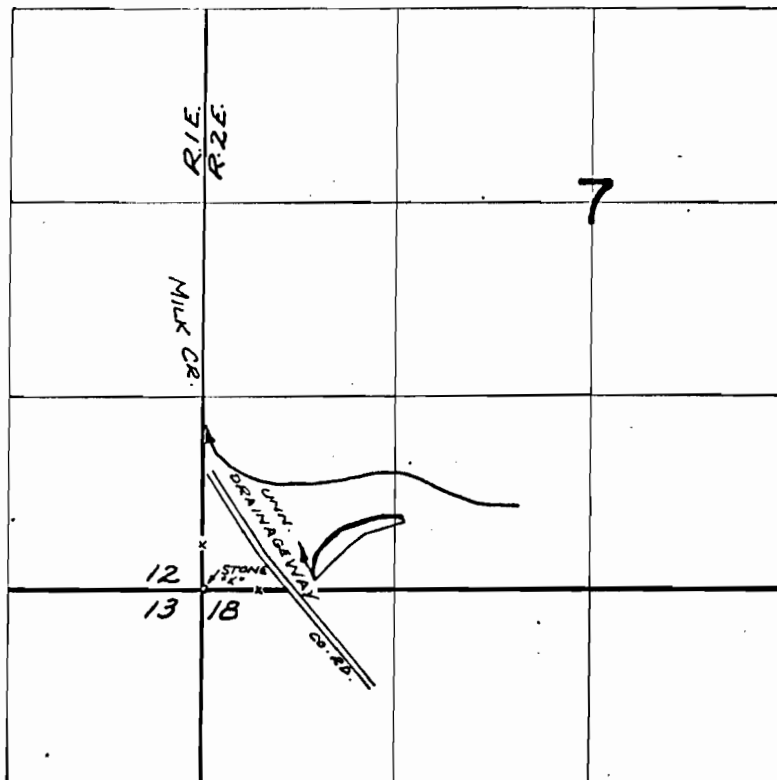

DIV. PT. LOC: 120' N. & 760' E. FROM S.W. COR. SEC. 7

FINAL PROOF SURVEY
UNDER

Application No. ^{R-44158} ~~44159~~ Permit No. ^{R-5095} ~~32926~~
IN NAME OF

J. HAYRE

Surveyed JULY 27, 1973, by R. MUCKEN