


T.4S.R.1&2E.W.M.

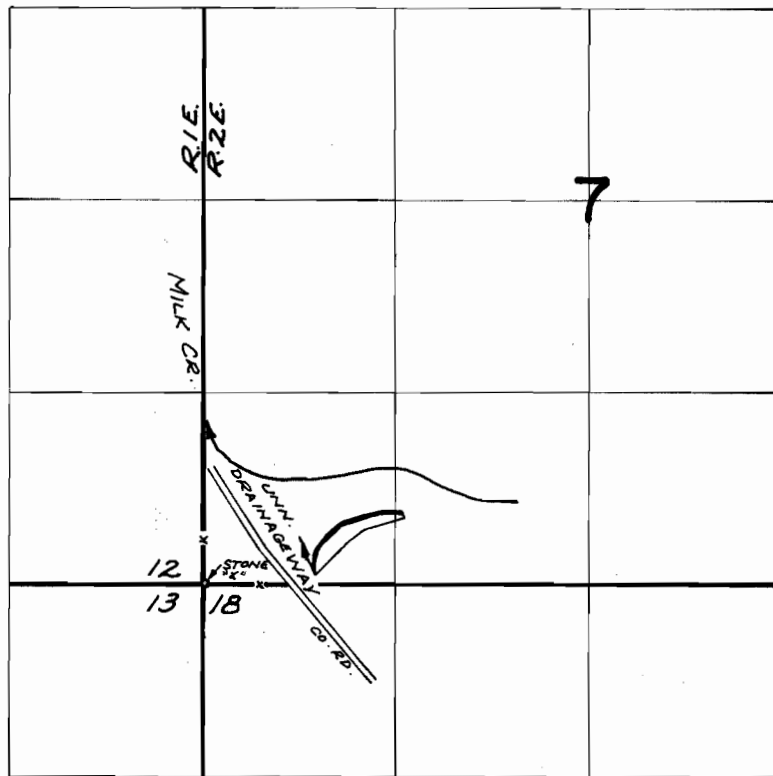

DIV. PT. LOC: 120' N. & 760' E. FROM S.W. COR. SEC. 7

FINAL PROOF SURVEY
UNDER

Application No. R-44158 Permit No. R-5095
44158 32274
IN NAME OF

J. HAYRE

Surveyed JULY 27, 1973, by R. MUGGEN