


T.3S.R.3E.W.M.

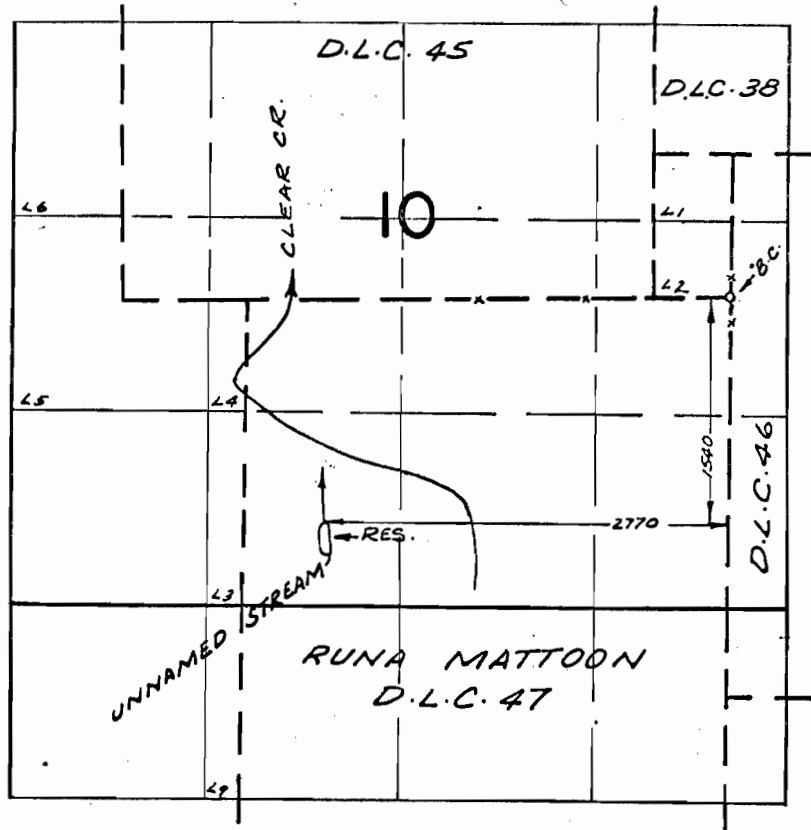

FINAL PROOF SURVEY UNDER

Application No. R-45670 Permit No. R-5410
45671 34075
IN NAME OF

JOHN C. MCKENZIE

Surveyed AUG. 15, 1973, by R. MUCKEN