


T.3S.R.3E.W.M.

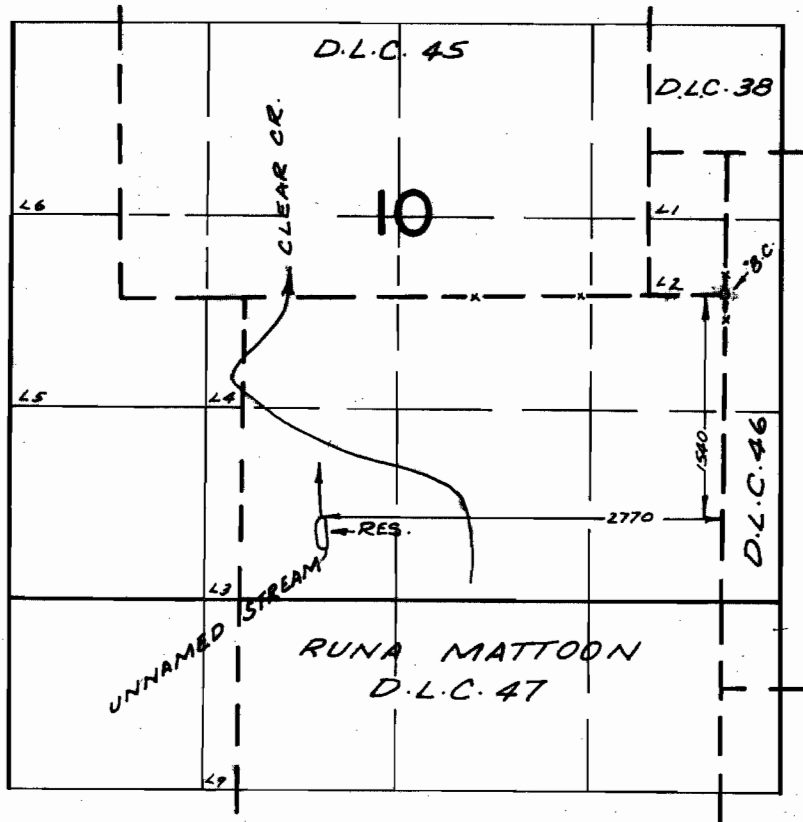

FINAL PROOF SURVEY UNDER

R-45670 R-5410
Application No. 45671 Permit No. 34075
IN NAME OF

JOHN C. MCKENZIE

Surveyed AUG. 15, 1973, by R. MUGGEN