


T.3S. R.4E. W.M.

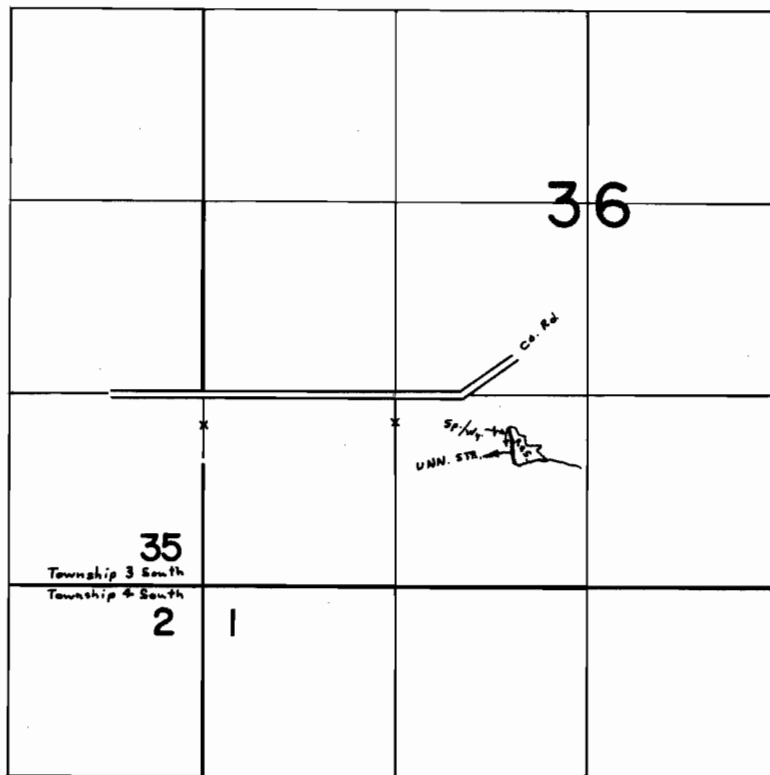

Div. Pt. Loc: 920' N. & 2130' E. from S.W. cor. Sec. 36

FINAL PROOF SURVEY
UNDER

Application No. R-47879 47880 Permit No. R-5649 35244

IN NAME OF

MRS. MERLYN C. LOERKE

Surveyed Oct. 2, 1973, by R. MUCKEN