


T.2&3S.R.3E.W.M.

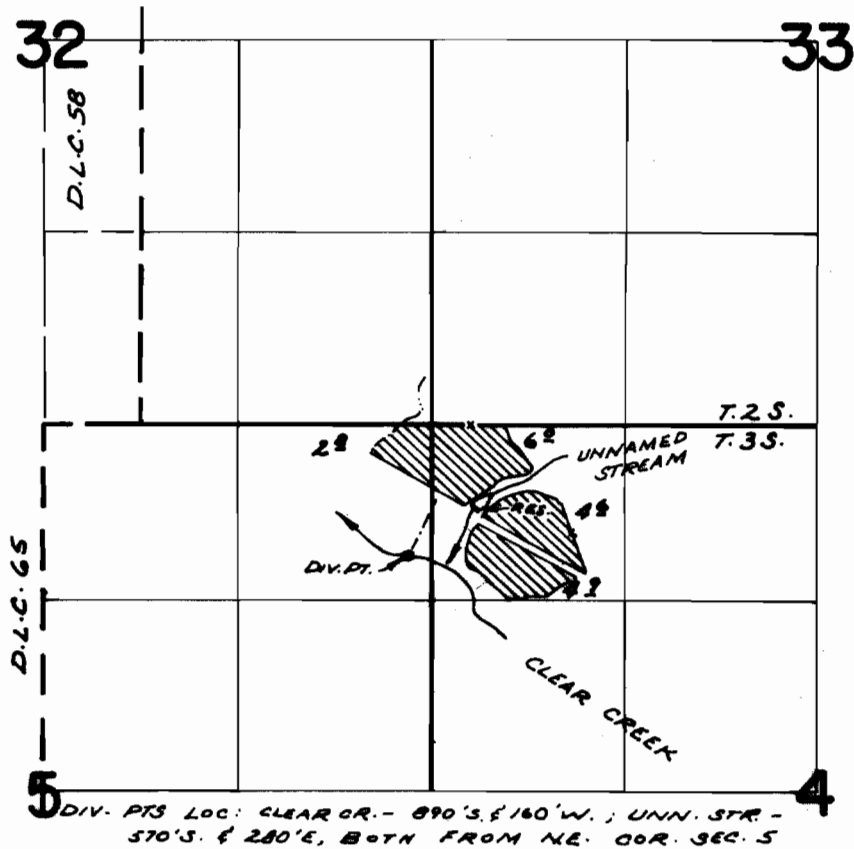

FINAL PROOF SURVEY UNDER

Application No. R.49040 29041 Permit No. R.5856 26151
IN NAME OF

JAMES P. & NANCY N. GILLILAN

Surveyed AUG. 15 1973, by R. MUGKEN