


T. 10 S., R. 4 W., W.M.

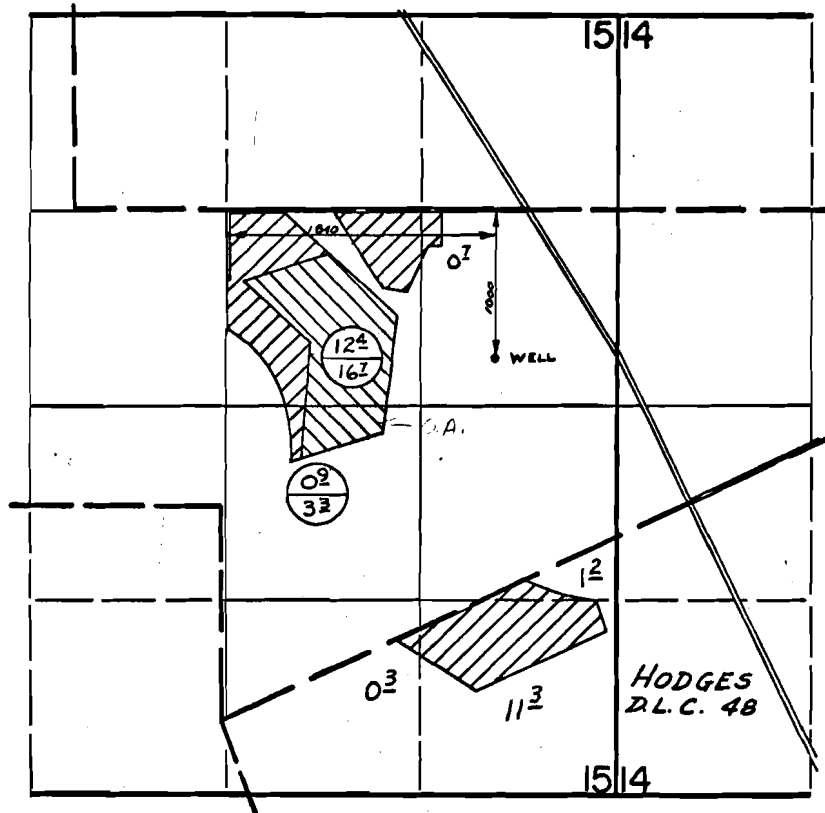

FINAL PROOF SURVEY UNDER

Application No. G-3829 Permit No. G-3609
IN NAME OF

LELAND HILL

Surveyed March 23 1973, by D. NORBY

G-3609
DJ-211-159 2