


P. 30005
411695

T.39S. R.18E. W.M.

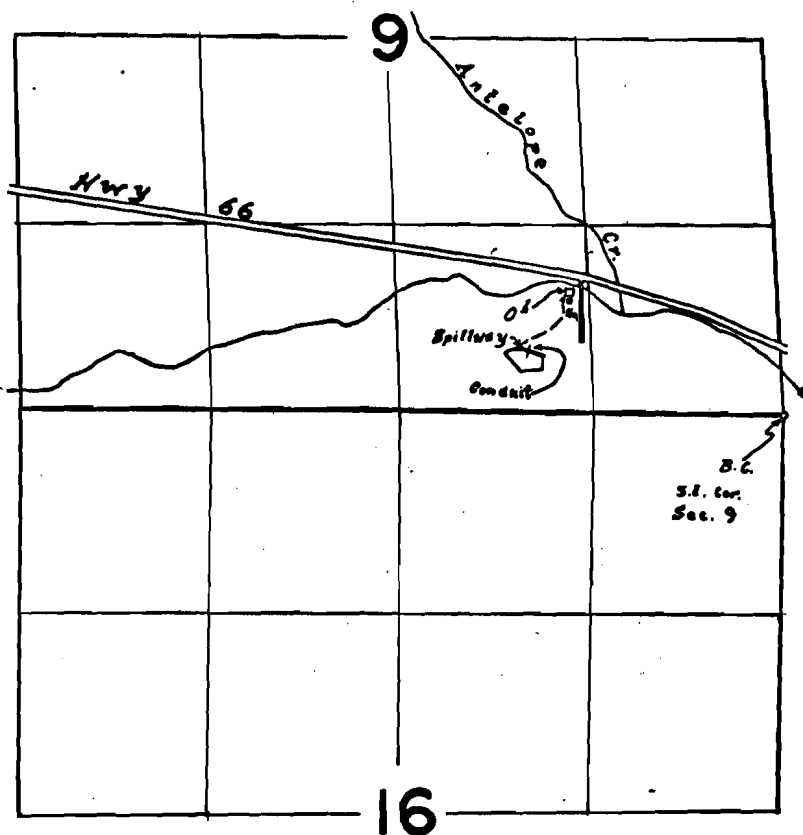

Div. Pt. 300. 460' N. of 1740' W. from S.E. cor. Sec. 9

FINAL PROOF SURVEY
UNDER

R-40230

R-4494

Application No. 40231 Permit No. 30005
IN NAME OF

CHRISTEL BRENNAN

Surveyed 19 Sept. 1972, by L.E. Gould