


T.18S., R.5W., W.M.

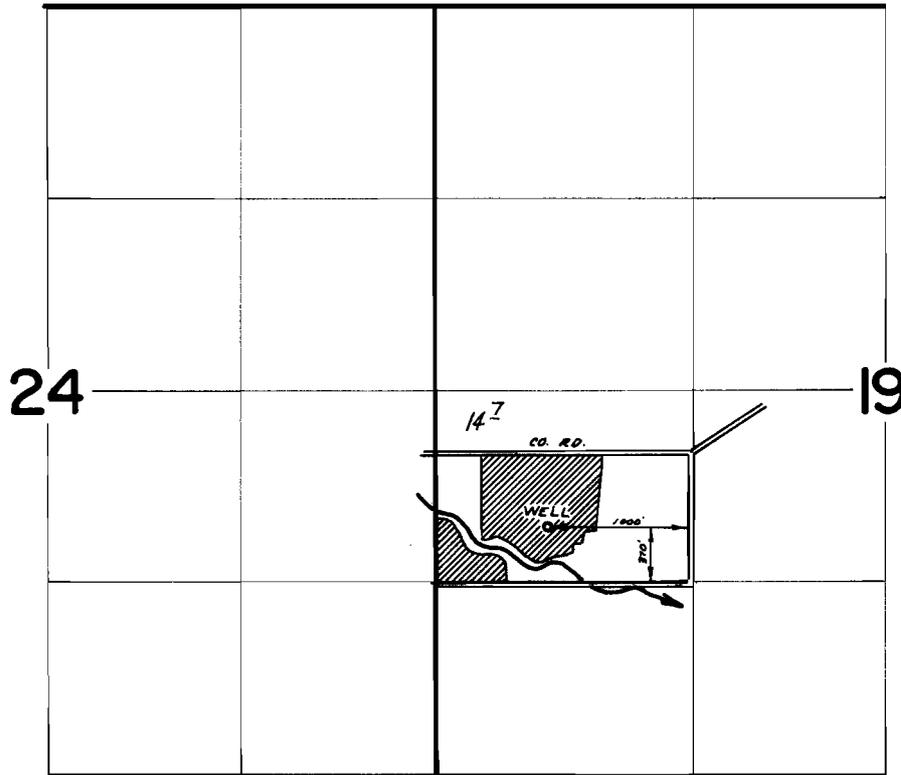

FINAL PROOF SURVEY
UNDER

Application No. G-5113 Permit No. G-4853
IN NAME OF

RUDY & OPAL POWELL

Surveyed June 14 1973, by D. Norby