
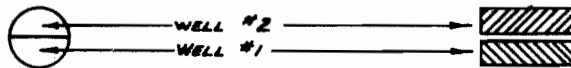


T.16S., R.3W., W.M.

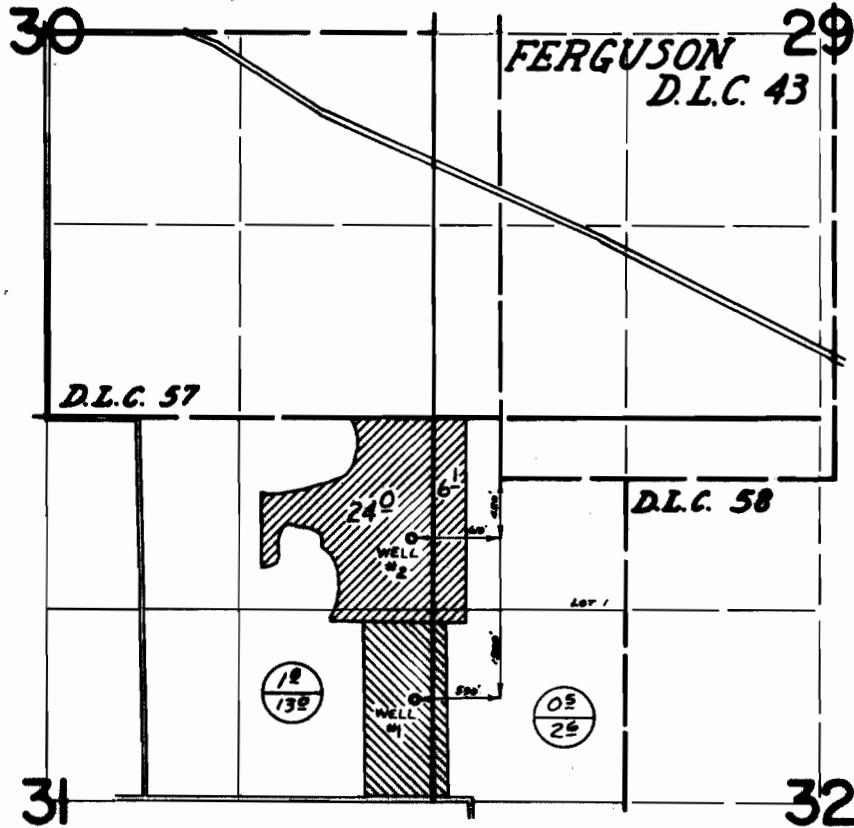

FINAL PROOF SURVEY
UNDER

Application No. G-5781 Permit No. G-4965
IN NAME OF

BOB D. & KATHRYN DOWNING

Surveyed MAY 1 1973, by D. NORBY