


T.19S. R.11&12 W. W.M.

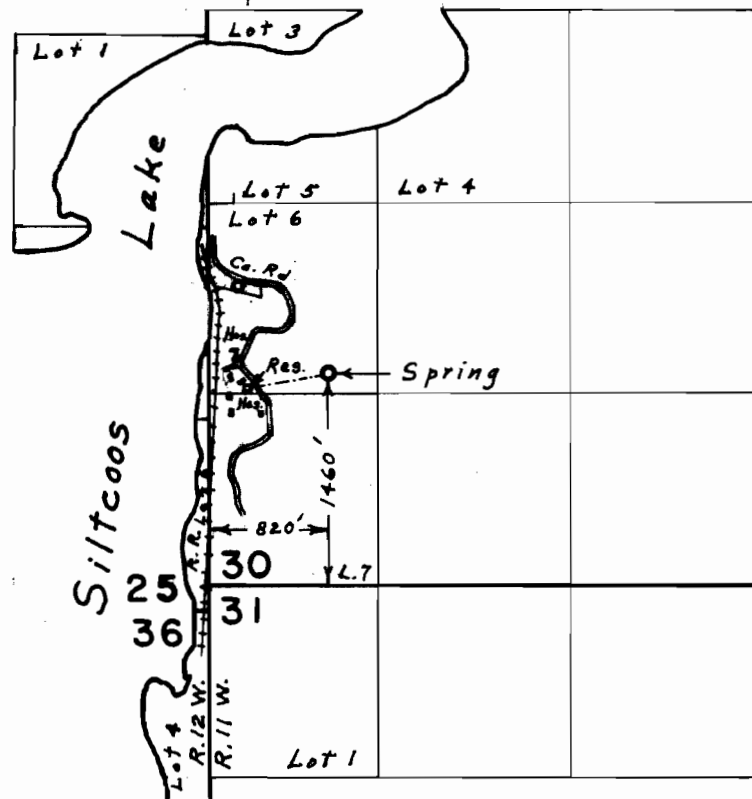

FINAL PROOF SURVEY
UNDER

Application No. 43544 Permit No. 32573
IN NAME OF

JAMES CHRISTENSEN JR.

Surveyed July 20, 1973, by L. E. Gould