


T.18S., R.3W., W.M.

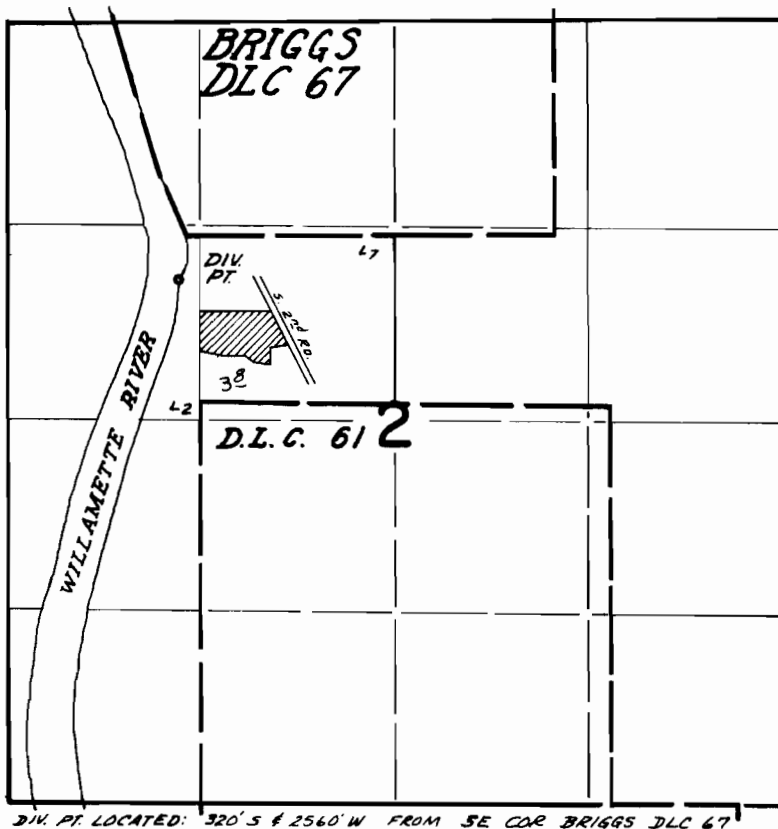

**FINAL PROOF SURVEY**  
UNDER

Application No. 46122 Permit No. 34458  
IN NAME OF

ORVIL E MITCHELL

Surveyed June 13 1973, by D. NORBY