


T.16S.,R.2W.,W.M.

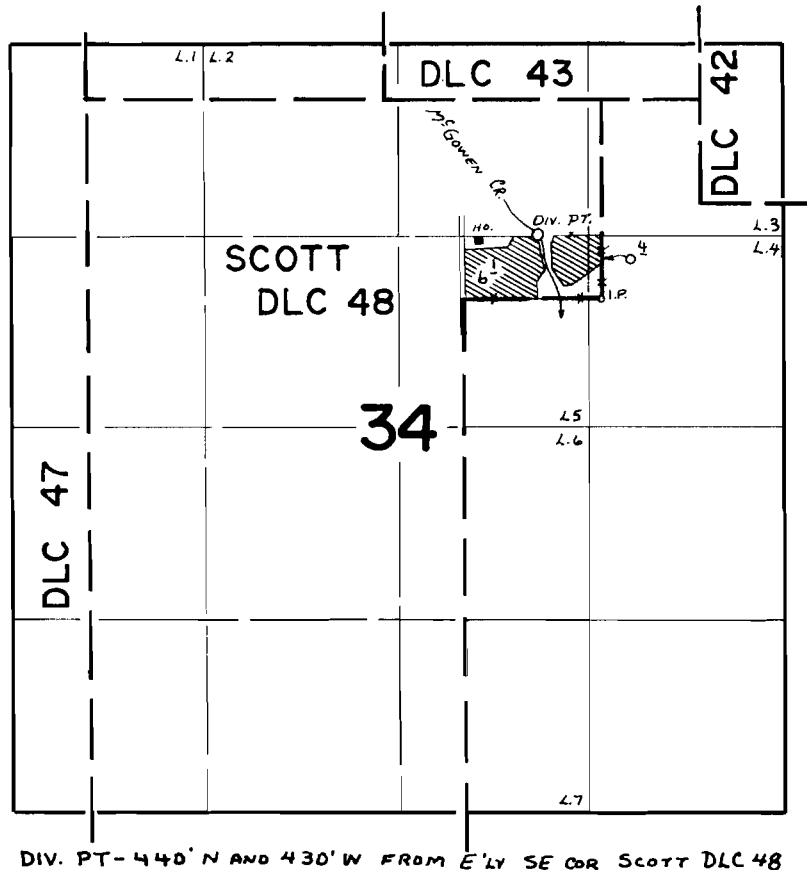

FINAL PROOF SURVEY
UNDER

Application No. 46356 Permit No. 34660
IN NAME OF

DONALD E. & JEANNE MATHIAS

Surveyed SEPT. 25 1974, by L. TOLL