


T.19S. R.11&12W. W.M.

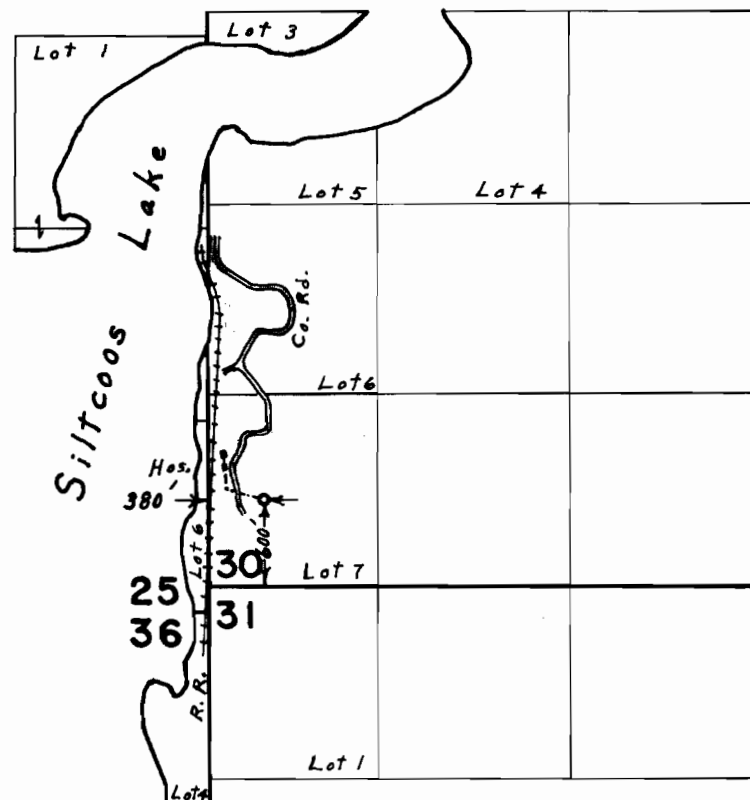

FINAL PROOF SURVEY
UNDER

Application No. 48732 Permit No. 35509
IN NAME OF

JAMES E. & BARBARA M. MORGAN

Surveyed July 9, 1974, by L. E. Gould