


T.17S., R.2W., W.M.

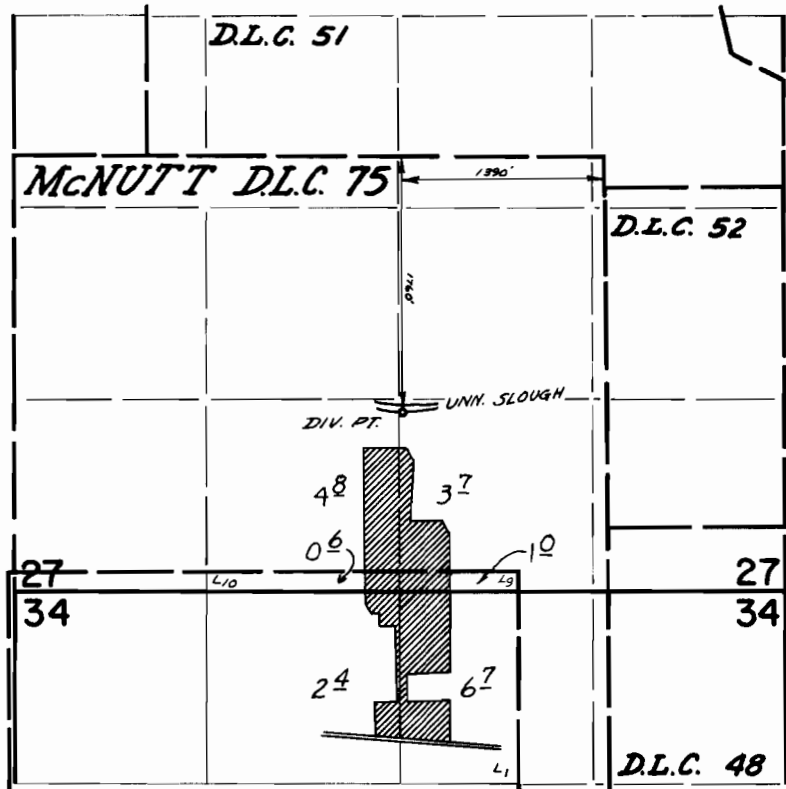

FINAL PROOF SURVEY
UNDER

Application No. 48934 Permit No. 35827
IN NAME OF

SPRINGFIELD SCHOOL DISTRICT NO 19

Surveyed MAY 4 1973, by D. NORBY