


T.16S.R.3W.W.M.

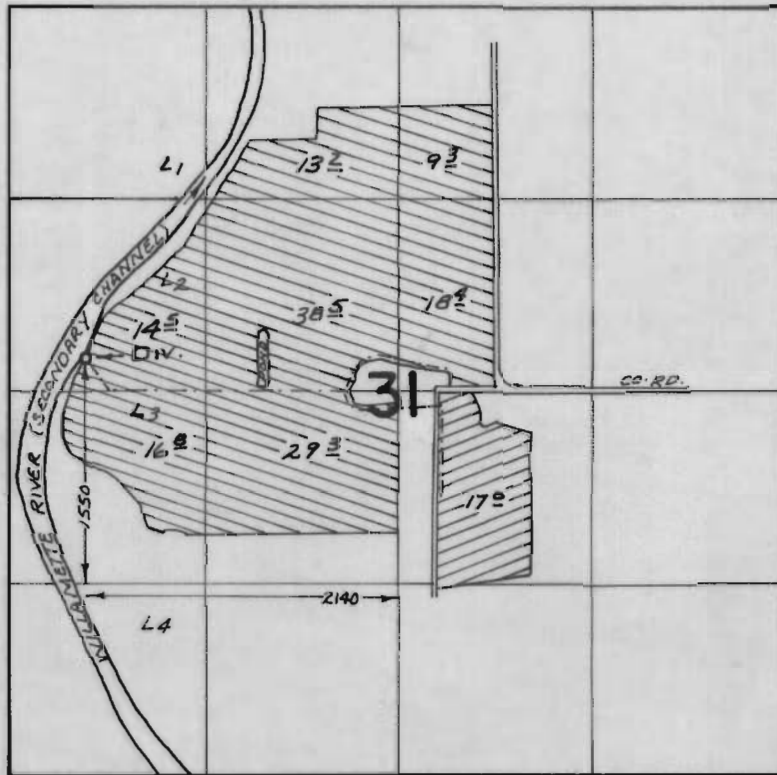

 - PRIMARY  - SUPPLEMENTAL

FINAL PROOF SURVEY
UNDER

Application No. 42885 Permit No. 35882
IN NAME OF

HARRY HARBERT

Surveyed SEPT. 6, 1973, by R. MUCKEN