


T.16S., R.2W., W.M.

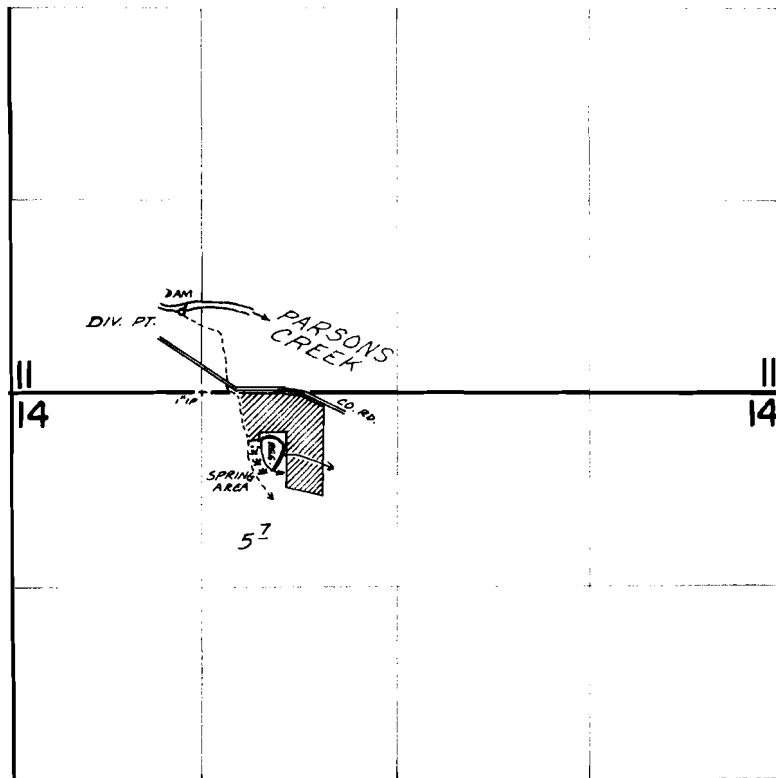

PARSONS CR. DIV. PT. LOC.: 550' N & 130' W FROM NW COR. NE $\frac{1}{4}$ NW $\frac{1}{4}$ SEC. 14.
RESERVOIR LOCATED: 440' S & 560' E FROM NW COR. NE $\frac{1}{4}$ NW $\frac{1}{4}$ SEC. 14.

FINAL PROOF SURVEY
UNDER

Application No. R-43571 44657 Permit No. R-5264 33327
IN NAME OF

TERRY CONNOLLY

Surveyed MAY 1 1973 by D. NORBY