


T. 18 S., R. 4 W., W.M.

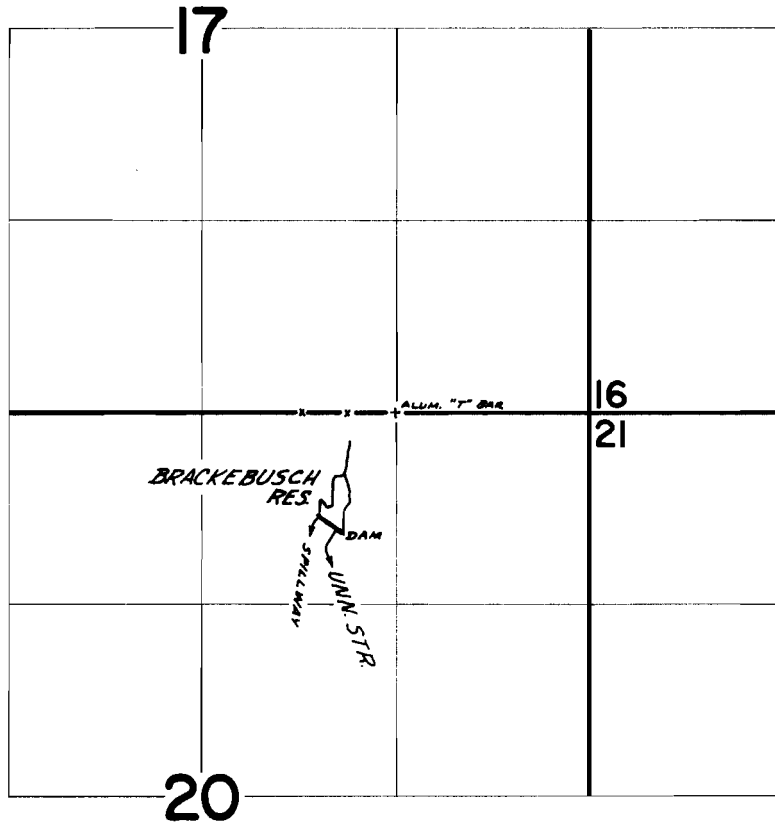

FINAL PROOF SURVEY
UNDER

Application No. R-46081 Permit No. R-5482
IN NAME OF

ESTATE OF CARL O. BRACKEBUSCH

Surveyed June 13 1973, by D. Norey