


T.18S., R.5W., W.M

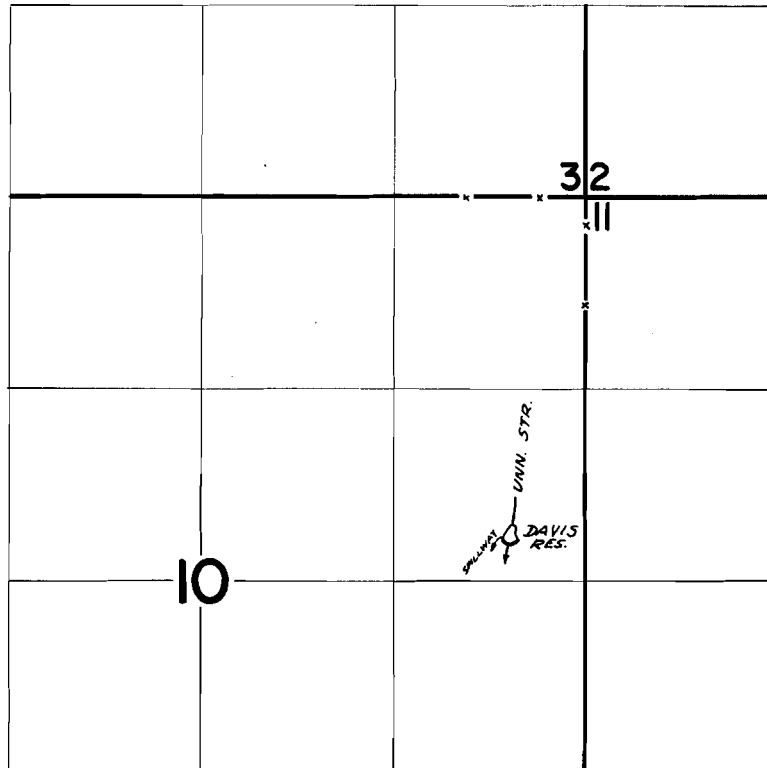

FINAL PROOF SURVEY
UNDER


Application No. R-47789 Permit No. R-5872
IN NAME OF

AUGUSTAS STARES

Surveyed June 15 19 73, by D. Norby

RECEIVED
DEC 14 1970
STATE ENGINEER
SALEM, OREGON

RECEIVED
JAN 19 1971
STATE ENGINEER
SALEM, OREGON

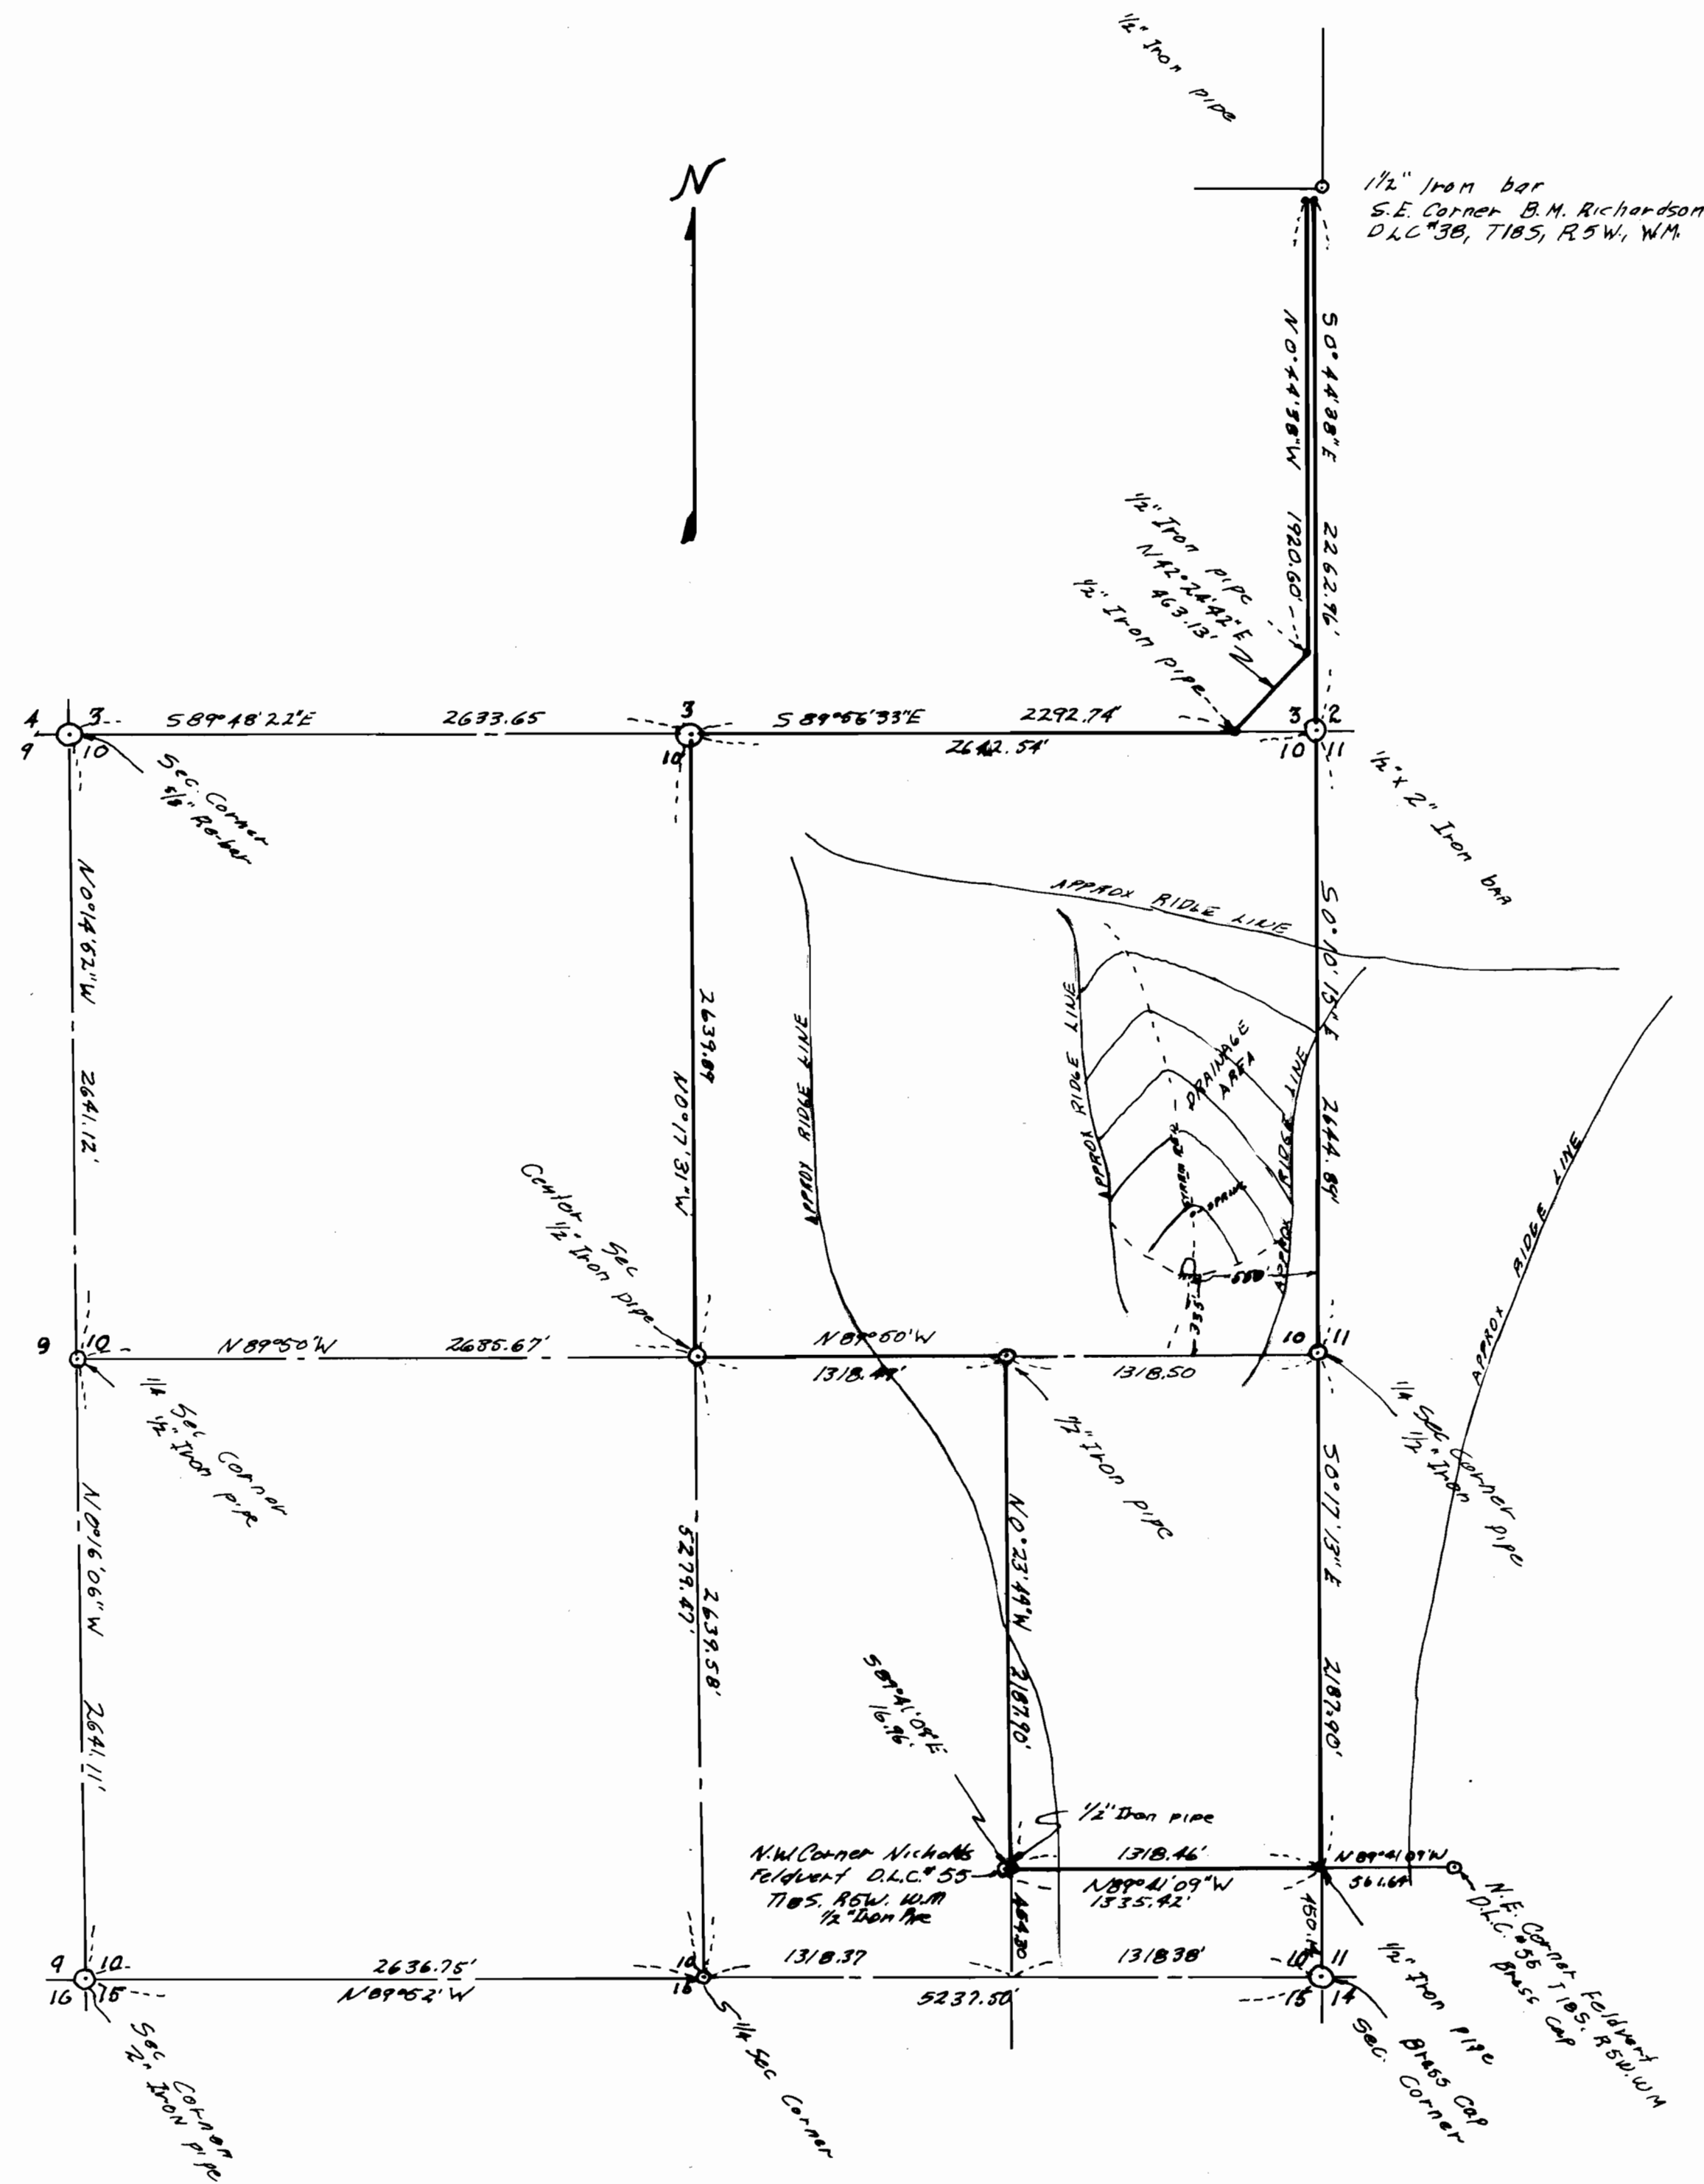

Application No. R-47789
Permit No. R-5872



WINLAR PROPERTIES		
SCALE: 1" = 600'	APPROVED BY	DRAWN BY
DATE: 12-7-35		V. LARSON
DAVIS DAM		
		DRAWING NUMBER