
T.19S.R.44E.W.M.

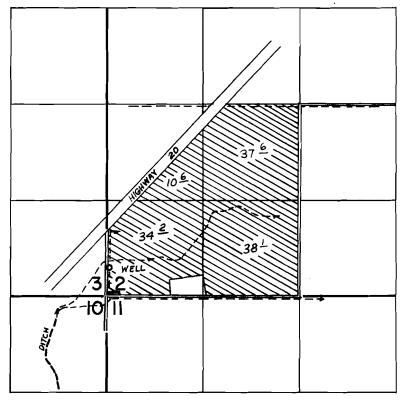

WELL 410' N. AND 8'E. FROM SW. COR. SEC. 2

FINAL PROOF SURVEY

Application No. G-5071 Permit No. G-4788
IN NAME OF
ALBERT ZUEGER

Surveyed AUG 24 19 73, by L.E. GOULD