


T. 13 S. R. 11 W. W. M.

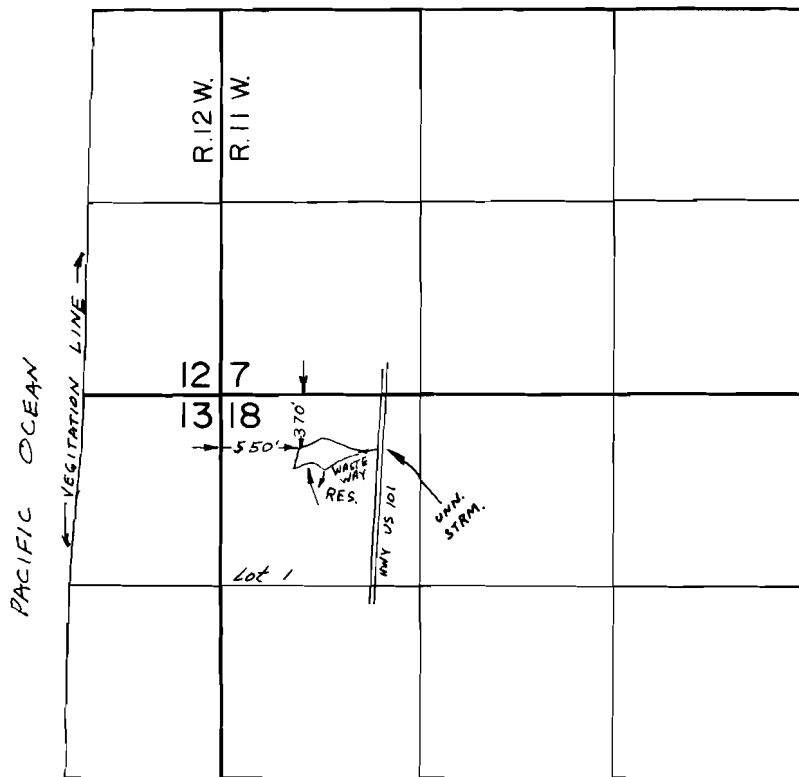

FINAL PROOF SURVEY
UNDER

R- 42076 R- 4716
Application No. 42077 Permit No. 31209
IN NAME OF

FRANK L. HALL

Surveyed JUN 7 1974, by L H NUNN