


T.9 S.R.I.W.W.M.

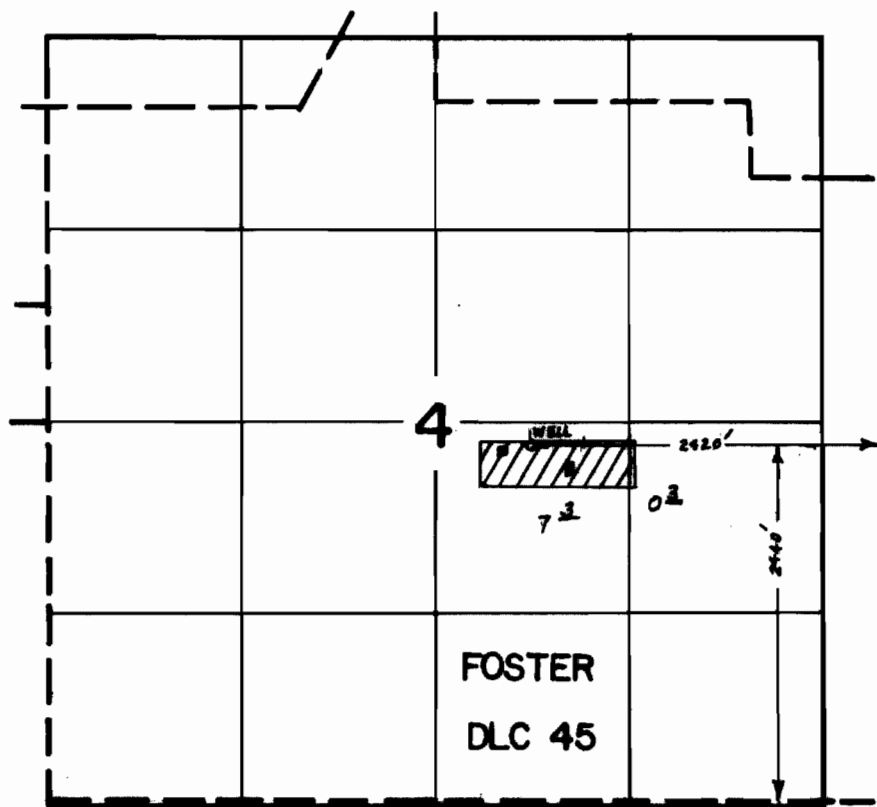

FINAL PROOF SURVEY
UNDER

Application No. G-5905 Permit No. G-5028
IN NAME OF

VERNON A. & BETTY SATTLEY

Surveyed MAY 17 1973, by L.E. GOULD