


T.1N. R.2E. W.M.

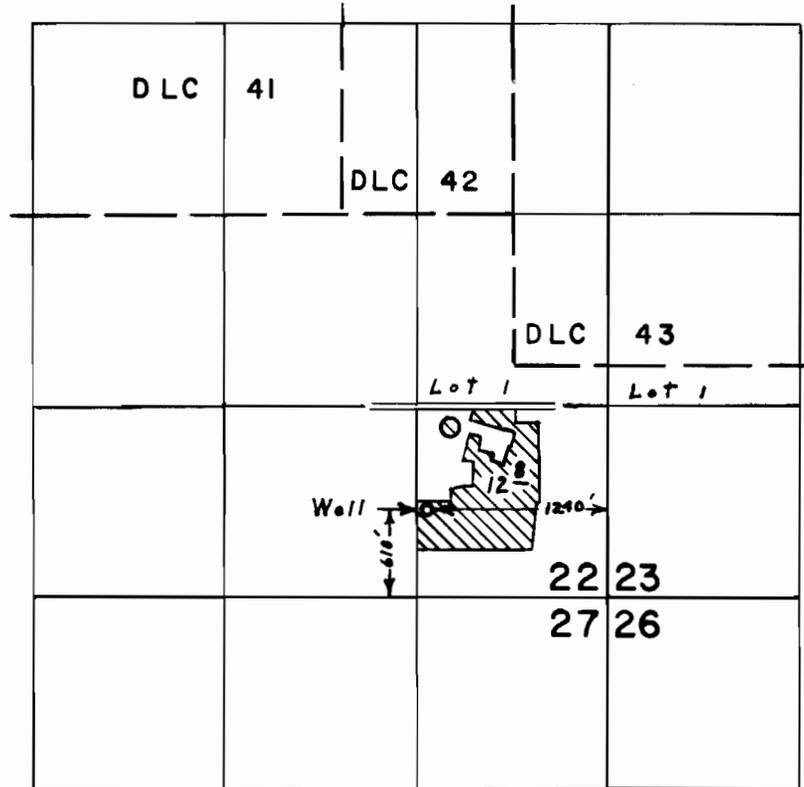

FINAL PROOF SURVEY UNDER

Application No. G-2193. Permit No. G-2018.
IN NAME OF

PARKROSE SCHOOL DISTRICT NO. 3

Surveyed May 11, 1973, by L. E. Gould.