


T.1 S. R.4 E. W.M.

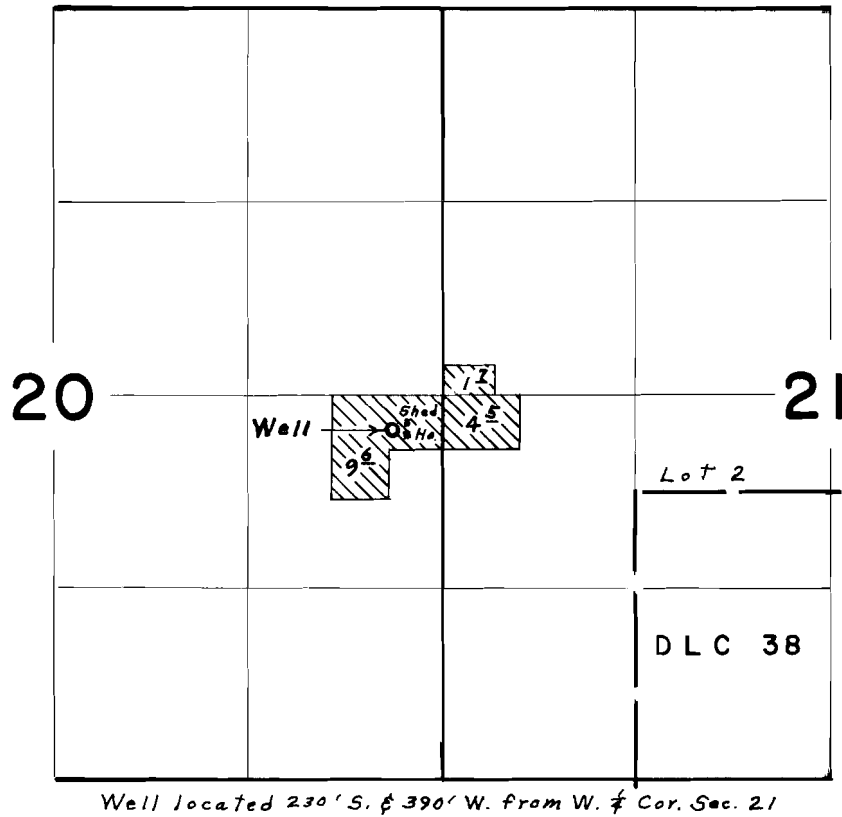

FINAL PROOF SURVEY
UNDER

Application No. G-5044 Permit No. G-4754
IN NAME OF

JOHN W. WILLIAMS

Surveyed Sept. 12, 1973, by L. E. Gould