


T.7S. R.4W. W.M.

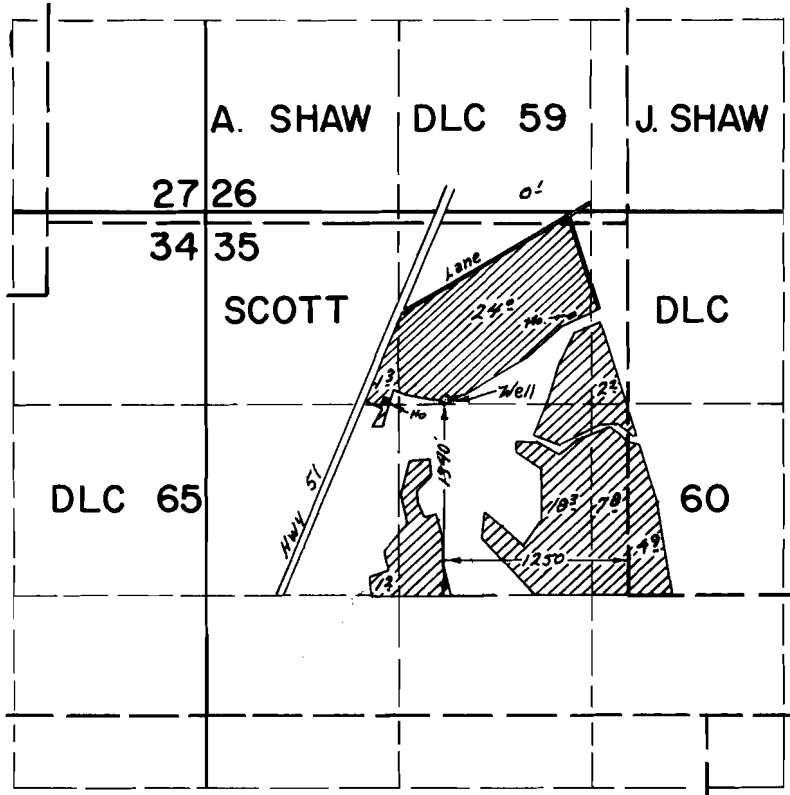

**FINAL PROOF SURVEY**  
UNDER

Application No. B-4346 Permit No. B-4103

IN NAME OF  
THE ESTATE OF  
**EDWARD E. MUELLER**

Surveyed July 2 1973, by R. G. Mucken