
T.9S. R.384W. W.M.

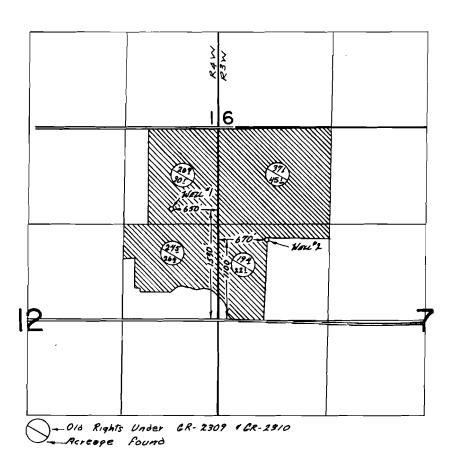

FINAL PROOF SURVEY

Application No. 6-5097 Permit No. 6-4610 IN NAME OF
GERALD MORLAN
Surveyed March 26 19 79 by R. C. Mucken