





T.9S. R.4W. W.M.

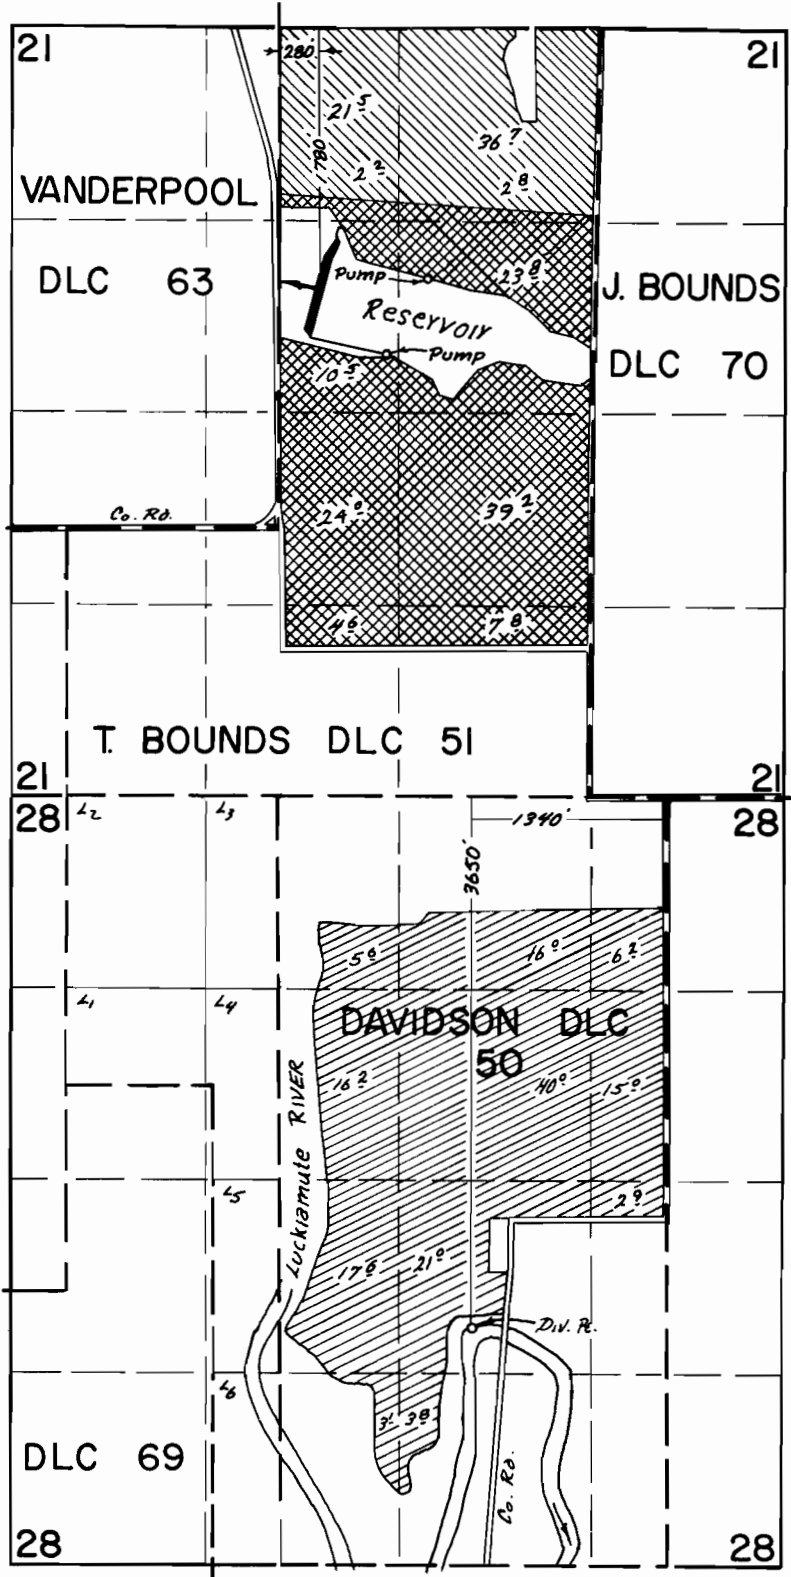

-  Primary P. # 31202
-  Primary P. # 33213
-  Primary P. # 32224
Supplemental P. # 33213

FINAL PROOF SURVEY

UNDER
 41713 31202
 43131 32224
 Application Nos. R-45242 Permit Nos. R-5155
 45243 33213

IN NAME OF
DESSERT SEED COMPANY INC.

Surveyed March 21, 1973, by R. G. MUCKEN