T.8&9S. R.5&6W. W.M.

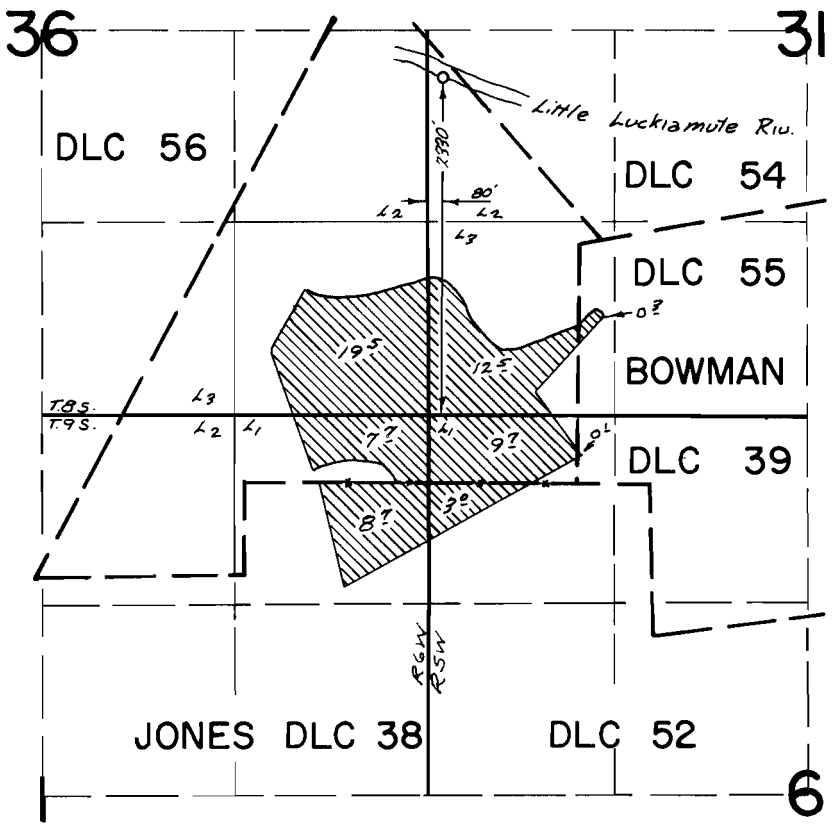

FINAL PROOF SURVEY
UNDER

Application No. 41792 Permit No. 31286
IN NAME OF

DR. C. J. MOSER

Surveyed APRIL 2 19 73, by R.G. Mucken

DFP-111-98