


T.9S. R.5W. W.M.

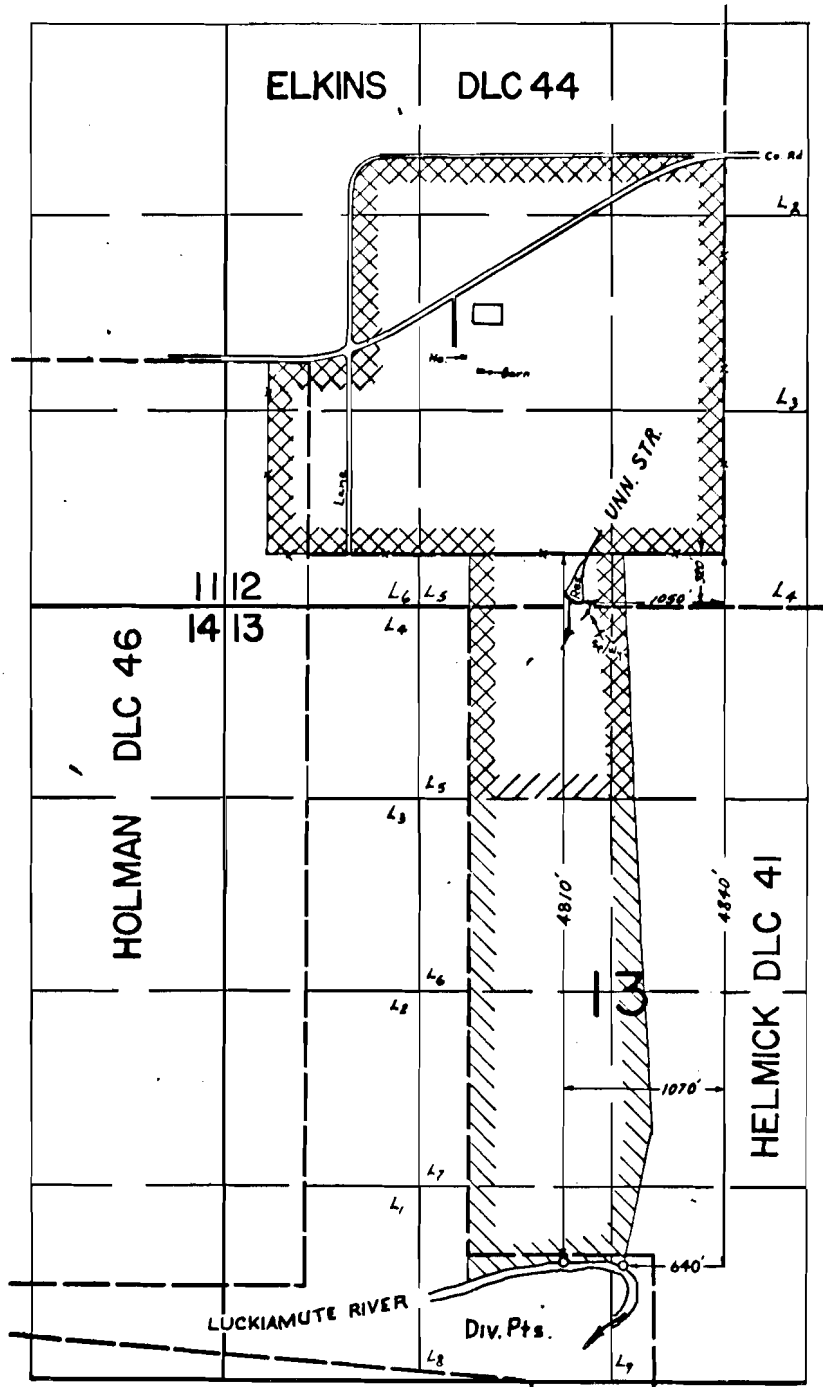

FINAL PROOF SURVEY UNDER

- Luckiamute R.

- Unn. Str. & Res.

Application No. 43429 R-43428 Permit No. 32469 R-4985
IN NAME OF

LEONARD PETERS

Surveyed MARCH 22, 1973, by R. MUCKEN