


# T.7S. R.4W. W.M.

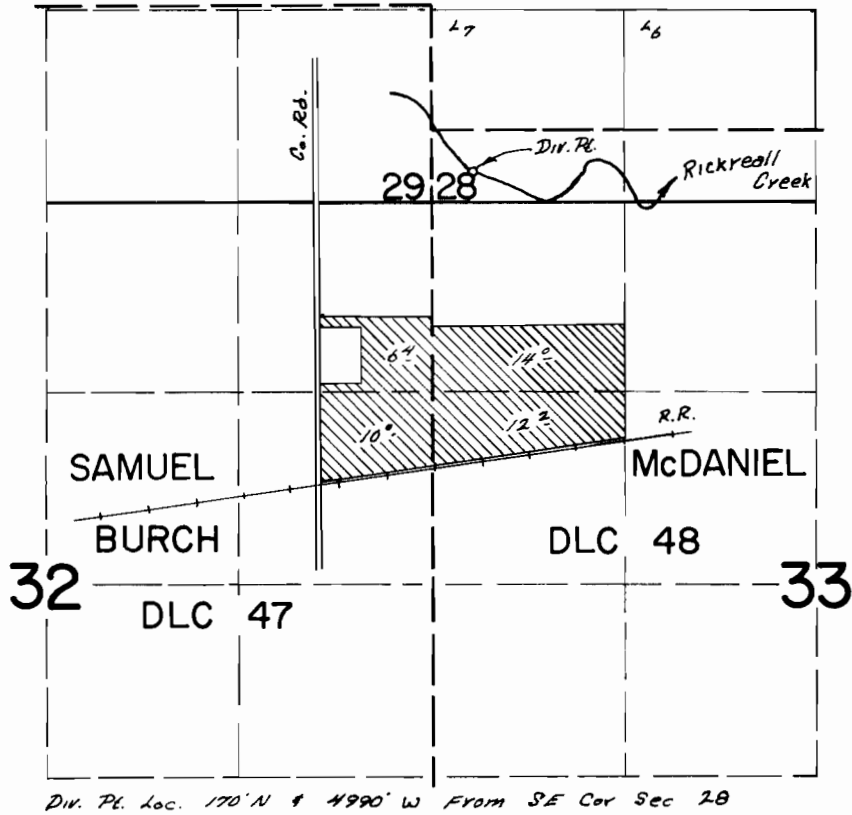

## FINAL PROOF SURVEY UNDER

Application No. 44707 Permit No. 33537  
IN NAME OF

GARFIELD L. ROTH

Surveyed APRIL 4 1973, by R.G. Mucken