


T.8S. R.6W. W.M.

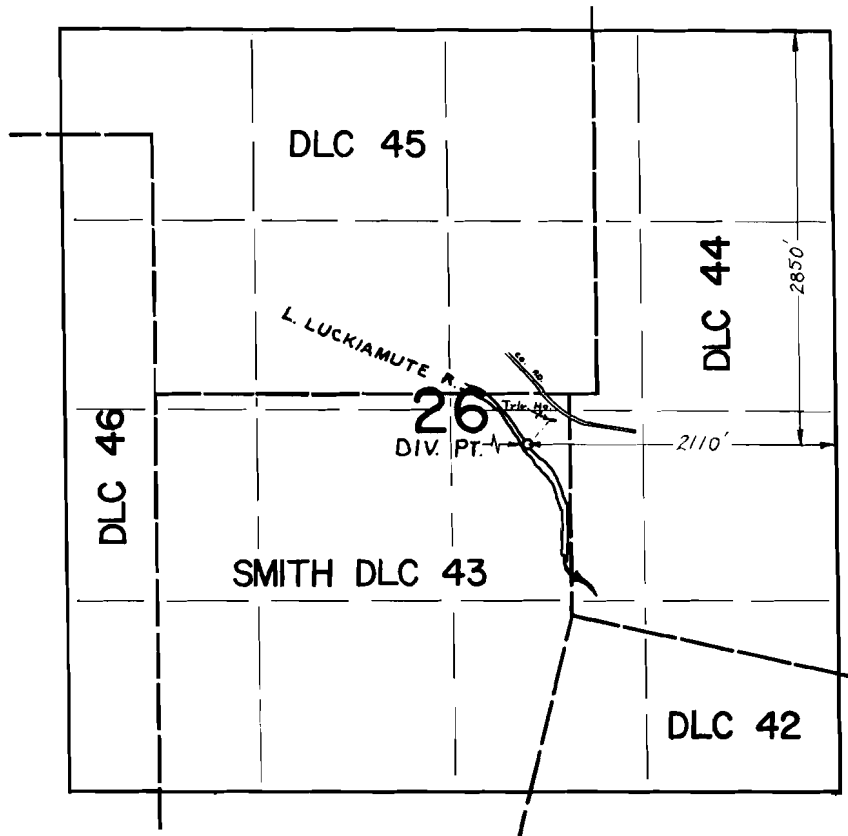

**FINAL PROOF SURVEY**  
UNDER

Application No. 47252 Permit No. 34882  
IN NAME OF

**L. A. TROTTER**

Surveyed MARCH 28, 1973, by R. MUCKEN