


T. 9S. R. 38&4W. W.M.

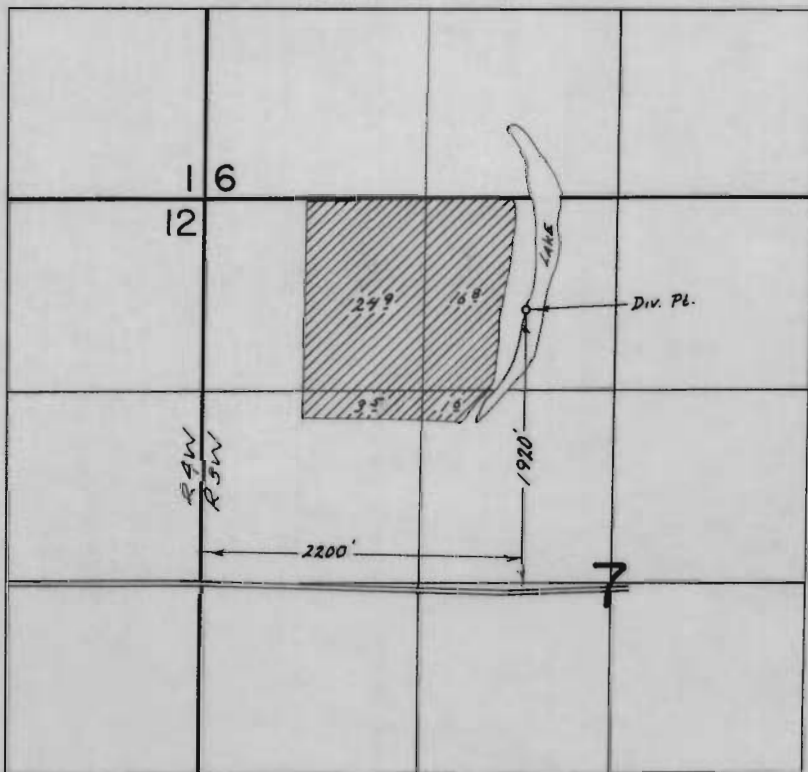

FINAL PROOF SURVEY
UNDER

Application No. 468194 Permit No. 341896
IN NAME OF

GERALD MORLAN

Surveyed March 26 1977 by R. G. Mucken